

# LABOR AND MATERIALS


1	Copper Lead	Connection	3/4	\$
1	Curb	Cock Valve T.S. & V.	3/4 in.	\$
1	Service box Old returned	Short 3-1/2 x 4-1/2 Long 4-1/2 x 5-1/2		\$
12	Ft.	3/4 in. Copper G.I. Ct.	Pipe at	\$
	Nipples		in. at	\$
	Bushings		to in. at	\$
	Red'g			\$
	Inc'g			\$
	Union		in. at	\$
	Meter		in. at	\$
				\$
	Compound Joints at			\$
	Maintenance Foreman			\$
	Hrs. Water Maint. Man - 1 at			\$
	Hrs. Water Maint. Man - 2 at			\$
	Hrs. Garage Foreman		at	\$
	Hrs. Labor		at	\$
	Hrs. Compressor at			\$
				\$
	Trucking			\$
	Pav't Patch			\$
				\$
				\$
				\$
				\$

GRANT

St. \_\_\_\_\_  
Pt. \_\_\_\_\_  
Ave. No. 7

Name of Owner

Labor and Mat'l. Report 19 35, Oct. 8

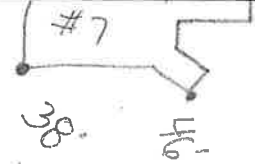

● Curb Box

4 Main

Elev. of Main at tap 4 1/2

Gate at ●

● Gate at



● Curb Box

" 9' 1/2 " 0' 6"





2'9 1/2" 4'6"

● Curb Box



● Gate at


● Gate at



Elev. of Main at tap 4'1 1/2"

Main 4

● Curb Box

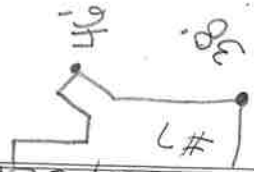

Labor and Mat'l. Report 1935 Oct. 8



Name of Owner

St. Ave. No. 7

GRANT