

LABOR AND MATERIALS


1 Copper } Connection 3/4" \$
 Lead }
 1 Curb } Cock } Copper to Copper
 Valve } in. 1/2" \$
 T.S. & V. }
 1 Service box { Short 3 1/2 x 4 1/2 } \$
 Old returned { Long 4 1/2 x 5 1/2 } \$
 Butt or Rdway }
 23 Ft. 3/4 in. { Copper } Pipe at \$
 { ~~Cop.~~ }
 { ~~Cop.~~ }
 Nipples in. at \$
 Bushings to in. at \$
 Red'g }
 Inc'g } Coupl'gs to in. at \$
 Union in. at \$
 Meter in. at \$
 Lead Joints at \$
 Compound Joints at \$
 Maintenance Foreman \$
 Hrs. Water Maint. Man-1 at \$
 Hrs. Water Maint. Man-2 at \$
 Hrs. Garage Foreman at \$
 Hrs. Labor at \$
 Hrs. Compressor at \$
 Compensation Ins. at \$ per C \$
 Trucking \$
 Pav't Patch \$
 Tap Made By St. Johns & Co \$
 O'head Sept-12-1973 \$
 \$

GRANT

St. Pt. Ave. No. 30

Name of Owner PUT RAVENNA

Labor and Mat'l. Report Sept 12 1973

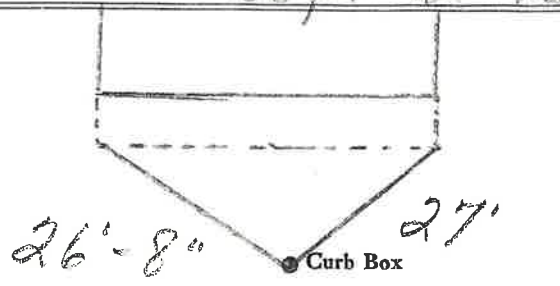

4" Main Elev. of Main at tap 4'
 Gate at • Gate at

● Curb Box