

LABOR AND MATERIALS


1	Copper Lead	Connection	3/4"	\$	
1	Curb	Cock Valve F.S. & V.	3/4" in.	\$	
1	Service box Old returned	{ Short 3-1/2 x 4-1/2 Long 4-1/2 x 5-1/2 }		\$	
24	Ft.	3/4 in. { Copper St. St. }	Pipe at	\$	
	Nipples		in. at	\$	
	Bushings		to in. at	\$	
	Red'g			\$	
	Inc'g			\$	
	Union		in. at	\$	
	Meter		in. at	\$	
				\$	
	Compound Joints at			\$	
	Maintenance Foreman			\$	
	Hrs. Water Maint. Man - 1 at			\$	
	Hrs. Water Maint. Man - 2 at			\$	
	Hrs. Garage Foreman		at	\$	
	Hrs. Labor		at	\$	
	Hrs. Compressor at			\$	
				\$	
	Trucking			\$	
	Pav't Patch			\$	
				\$	
				\$	
GRANT

St. Ave. No. 32

Name of Owner

Labor and Mat'l. Report 1932, AUG. 15

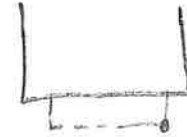

29' 19 1/2"

● Curb Box

4" Main

Elev. of Main at tap 4 1/2'

Gate at ●

● Gate at

● Curb Box

OLD TAP SHUT OFF AT MAIN