


LABOR AND MATERIALS

1	Copper Lead	Connection	3/4	\$	_____
1	Curb	Cock Valve T.S. & V.	3/4 in.	\$	_____
1	Service box	Short 3-1/2 x 4-1/2		\$	_____
	Old returned	Long 4-1/2 x 5-1/2		\$	_____
22	Ft.	Copper 6:1 C.T.	3/4 in.	Pipe at	\$ _____
	Nipples		in. at	\$	_____
	Bushings		to _____ in. at	\$	_____
	Red'g			\$	_____
	Inc'g			\$	_____
	Union		in. at	\$	_____
	Meter		in. at	\$	_____
	Compound Joints at			\$	_____
	Maintenance Foreman			\$	_____
	Hrs. Water Maint. Man - 1 at			\$	_____
	Hrs. Water Maint. Man - 2 at			\$	_____
	Hrs. Garage Foreman		at _____	\$	_____
	Hrs. Labor		at _____	\$	_____
	Hrs. Compressor at			\$	_____
	Trucking			\$	_____
	Pav't Patch			\$	_____
				\$	_____
				\$	_____
GRANT St. Pt. Ave. No. 36
 Name of Owner _____

Labor and Mat'l. Report 19 32, June 7

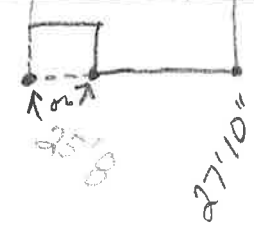

● Curb Box

4" Main

Elev. of Main at tap 4 1/2'

Gate at ●

● Gate at

● Curb Box

OLD TAP TO BE DUG UP