

LABOR AND MATERIALS

1	Copper } Connection	3/4	\$	_____
	Lead }			
1	Curb } Cock		\$	_____
	Valve }			
	T.G. & V. }			
1	Service box { Short 3-1/2 x 4-1/2		\$	_____
	Old returned { Long 4-1/2 x 5-1/2			
11	Ft. 1 in. { Copper		\$	_____
	G.I. }			
	Est. }			
	Pipe at		\$	_____
	Nipples		\$	_____
	Bushings		\$	_____
	Red'g		\$	_____
	Inc'g		\$	_____
	Union		\$	_____
	Meter		\$	_____
	Compound Joints at		\$	_____
	Maintenance Foreman		\$	_____
	Hrs. Water Maint. Man - 1 at		\$	_____
	Hrs. Water Maint. Man - 2 at		\$	_____
	Hrs. Garage Foreman at		\$	_____
	Hrs. Labor at		\$	_____
	Hrs. Compressor at		\$	_____
	Trucking		\$	_____
	Pav't Patch		\$	_____
			\$	_____
			\$	_____

GRANT

Ave. No. 39

Name of Owner

J.J. O'Keefe

Labor and Mat'l. Report 1925, Mar. 31

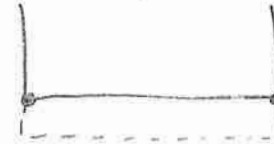

33 1/2" 31'

● Curb Box

4" Main

Elev. of Main at tap _____

Gate at ●

● Gate at _____

● Curb Box

33' 2"

31'

(ABOUT)
LABOR AND MATERIALS

_____ Copper } Connection _____ \$ _____
 _____ Lead }
 _____ Curb } Cock } _____ in. \$ _____
 _____ } Valve }
 _____ } T.S. & V. }
 13 Service box } Short 3-1/2 x 4-1/2 } ABOUT \$ _____
 Old returned } Long 4-1/2 x 5-1/2 }
 _____ Ft. _____ in. { Copper } Pipe at _____ \$ _____
 _____ } G.I. }
 _____ } C.I. }
 _____ Nipples _____ in. at _____ \$ _____
 _____ Bushings _____ to _____ in. at _____ \$ _____
 _____ Red'g _____
 _____ Inc'g _____ (TM)
 _____ Union _____ in. at _____ \$ _____
 _____ Meter _____ in. at _____ \$ _____
 _____ \$ _____
 _____ Compound Joints at _____ \$ _____
 _____ Maintenance Foreman _____ \$ _____
 _____ Hrs. Water Maint. Man - 1 at _____ \$ _____
 _____ Hrs. Water Maint. Man - 2 at _____ \$ _____
 _____ Hrs. Garage Foreman _____ at _____ \$ _____
 _____ Hrs. Labor _____ at _____ \$ _____
 _____ Hrs. Compressor at _____ \$ _____
 _____ \$ _____
 _____ Trucking _____ \$ _____
 _____ Pav't Patch _____ \$ _____
 _____ \$ _____
 _____ \$ _____
GRANT

St. Ave. No. 39

Name of Owner

Labor and Mat'l. Report 19

● Curb Box

4"

Main

Elev. of Main at tap

4'6"

Gate at ●

● Gate at

● Curb Box

New Sewer Line
 7/11/06 6" line to
 main put 8" BY 6 TIN
 need water some day
 dug to right of water
 AND SAS