


LABOR AND MATERIALS

1	Copper } Connection <u>3/4</u>	\$
1	Lead } Cock Valve T.S. & V. } <u>3/4</u> in.	\$
1	Service box { Short 3-1/2 x 4-1/2 } Old returned { Long 4-1/2 x 5-1/2 }	\$
27	Ft. <u>3/4</u> in. { Copper Gt. } Pipe at	\$
	Nipples _____ in. at	\$
	Bushings _____ to _____ in. at	\$
	Red'g	
	Inc'g	
	Union _____ in. at	\$
	Meter _____ in. at	\$
	_____	\$
	Compound Joints at	\$
	Maintenance Foreman	\$
	Hrs. Water Maint. Man - 1 at	\$
	Hrs. Water Maint. Man - 2 at	\$
	Hrs. Garage Foreman _____ at	\$
	Hrs. Labor _____ at	\$
	Hrs. Compressor at	\$
	_____	\$
	Trucking _____	\$
	Pav't Patch _____	\$
	_____	\$
	_____	\$
	_____	\$
	_____	\$

GRANT -St. Ave. No. 48
Name of Owner _____

Labor and Mat'l. Report 19 35, Oct. 10

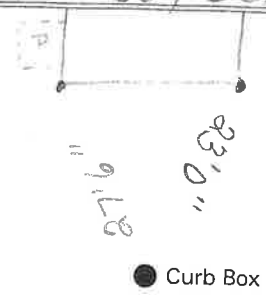

4" Main Elev. of Main at tap 4'
Gate at ● Gate at ●

● Curb Box

OLD TAP SHUT OFF AT MAIN