

LABOR AND MATERIALS


1	Copper	Connection	3/4	\$
1	Curb	Cock Valve	3/4 in.	\$
1	Service box	Short 3-1/2 x 4-1/2		\$
	Old returned	Long 4-1/2 x 5-1/2		\$
26	Ft.	Copper	3/4 in.	Pipe at \$
	Nipples		in. at	\$
	Bushings		to in. at	\$
	Red'g			
	Inc'g			
	Union		in. at	\$
	Meter		in. at	\$
	Compound Joints		at	\$
	Maintenance Foreman			\$
	Hrs. Water Maint. Man - 1		at	\$
	Hrs. Water Maint. Man - 2		at	\$
	Hrs. Garage Foreman		at	\$
	Hrs. Labor		at	\$
	Hrs. Compressor		at	\$
	Trucking			\$
	Pav't Patch			\$
				\$
				\$
GRANT

St. Pl. Ave. No. 52

Name of Owner

Labor and Mat'l. Report 19 35, OCT. 10

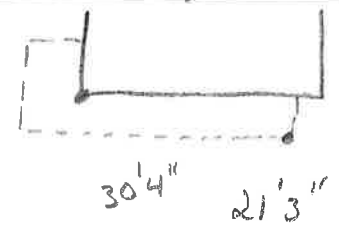

● Curb Box

4" Main

Elev. of Main at tap 4'

Gate at ●

● Gate at

● Curb Box

OLD TAP SHUT OFF AT MAIN