

# LABOR AND MATERIALS


<u>1</u>	Copper } Connection	<u>3/4</u>	\$	_____
<u>1</u>	Curb } Cock	<u>3/4</u> in.	\$	_____
	Wave } F.C. & V.			
<u>1</u>	Service box	{ Short 3-1/2 x 4-1/2 }	\$	_____
	<del>Old returned</del>	{ Long 4-1/2 x 5-1/2 }		
<u>10</u>	Ft. <u>3/4</u> in. } Copper	Pipe at	\$	_____
_____	Nipples _____ in.	at _____	\$	_____
_____	Bushings _____ to _____ in.	at _____	\$	_____
_____	Red'g			
_____	Inc'g			
_____	Union _____ in.	at _____	\$	_____
_____	Meter _____ in.	at _____	\$	_____
_____			\$	_____
_____	Compound Joints at _____		\$	_____
_____	Maintenance Foreman _____		\$	_____
_____	Hrs. Water Maint. Man - 1 at _____		\$	_____
_____	Hrs. Water Maint. Man - 2 at _____		\$	_____
_____	Hrs. Garage Foreman _____ at _____		\$	_____
_____	Hrs. Labor _____ at _____		\$	_____
_____	Hrs. Compressor at _____		\$	_____
_____			\$	_____
_____	Trucking _____		\$	_____
_____	Pav't Patch _____		\$	_____
_____			\$	_____
_____			\$	_____
_____			\$	_____
_____			\$	_____

GRANT

Ave. No. 70

Name of Owner \_\_\_\_\_

Labor and Mat'l. Report 1930, SEPT. 10

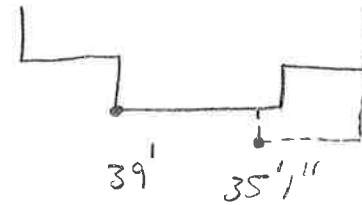

● Curb Box

6" Main

Elev. of Main at tap 4 1/2'

Gate at ●

● Gate at

● Curb Box

NEW HOUSE