

LABOR AND MATERIALS

1	Copper } Connection	3/4	\$	_____
	Lead } Cock		\$	_____
1	Curb } Valve	3/4 in.	\$	_____
		T.S. & V. }		
1	Service box { Short 3-1/2 x 4-1/2		\$	_____
	Old returned { Long 4-1/2 x 5-1/2		\$	_____
29	Ft. 3/4 in. { Copper		\$	_____
		G.I. }		
		C.I. }		
	Nipples _____ in. at _____		\$	_____
	Bushings _____ to _____ in. at _____		\$	_____
	Red'g _____		\$	_____
	Inc'g _____		\$	_____
	Union _____ in. at _____		\$	_____
	Meter _____ in. at _____		\$	_____
	Compound Joints at _____		\$	_____
	Maintenance Foreman _____		\$	_____
	Hrs. Water Maint. Man - 1 at _____		\$	_____
	Hrs. Water Maint. Man - 2 at _____		\$	_____
	Hrs. Garage Foreman _____ at _____		\$	_____
	Hrs. Labor _____ at _____		\$	_____
	Hrs. Compressor at _____		\$	_____
	Trucking _____		\$	_____
	Pav't Patch _____		\$	_____
	_____		\$	_____
	_____		\$	_____
GRANT

St.

Pl.


Ave. No.

81

Name of Owner

TAX ID # 302.19-8-12

Labor and Mat'l. Report 19 30, NOV. 26

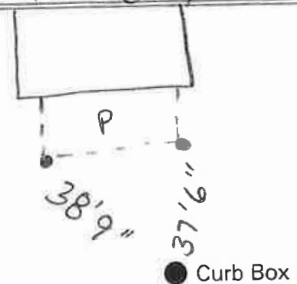

6 Main

Elev. of Main at tap 4 1/2

Gate at ●

● Gate at

● Curb Box

NEW HOUSE