

# LABOR AND MATERIALS

1	Copper } Connection	3/4"	\$	_____
1	Curb } Cock Valve	3/4 in.	\$	_____
		T.S. & V. }		
1	Service box	{ Short 3-1/2 x 4-1/2 }	\$	_____
	Old returned	{ Long 4-1/2 x 5-1/2 }	\$	_____
10	Ft. 3/4 in. { Copper } Pipe at		\$	_____
	Nipples	_____ in. at	\$	_____
	Bushings	_____ to _____ in. at	\$	_____
	Red'g			
	Inc'g			
	Union	_____ in. at	\$	_____
	Meter	_____ in. at	\$	_____
			\$	_____
	Compound Joints at		\$	_____
	Maintenance Foreman		\$	_____
	Hrs. Water Maint. Man - 1 at		\$	_____
	Hrs. Water Maint. Man - 2 at		\$	_____
	Hrs. Garage Foreman	_____ at	\$	_____
	Hrs. Labor	_____ at	\$	_____
	Hrs. Compressor at		\$	_____
			\$	_____
	Trucking		\$	_____
	Pav't Patch		\$	_____
			\$	_____
			\$	_____
GRANT St. Pt. Ave. No. 86


---

Name of Owner

---

Labor and Mat'l. Report 1925, Sept. 11

---

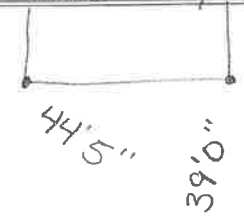

● Curb Box

6" Main Elev. of Main at tap 5'

---

Gate at ● ● Gate at

---

● Curb Box