

LABOR AND MATERIALS

Copper	} Connection	_____	\$ _____
Lead			
Curb	} Cock Valve T. S. & V. }	_____ in.	\$ _____
Service box	{ Short 3½ x 4½ Long 4½ x 5½ Buff or Rdway }	_____	\$ _____
Old returned			
30 Ft. ¹⁰ 30 ^{3/4} in.	{ Copper C.I. C.I. }	Pipe at _____	\$ _____
Nipples	in. at _____	\$ _____	
Bushings	to _____ in. at _____	\$ _____	
Red'g Inc'g	} Coupl'gs to _____ in. at _____	\$ _____	
Union	in. at _____	\$ _____	
Meter	in. at _____	\$ _____	
Lead Joints	at _____	\$ _____	
Compound Joints	at _____	\$ _____	
Maintenance Foreman		\$ _____	
Hrs. Water Maint. Man—1	at _____	\$ _____	
Hrs. Water Maint. Man—2	at _____	\$ _____	
Hrs. Garage Foreman	at _____	\$ _____	
Hrs. Labor—	at _____	\$ _____	
Hrs. Compressor	at _____	\$ _____	
Compensation Ins. at \$ _____	per C. _____	\$ _____	
Trucking		\$ _____	
Pav't Patch		\$ _____	
		\$ _____	
		\$ _____	
O'head		\$ _____	
		\$ _____	


GRANT

St. _____
Pl. _____
Ave. No. 89

Name of Owner _____

Labor and Mat'l. Report

19

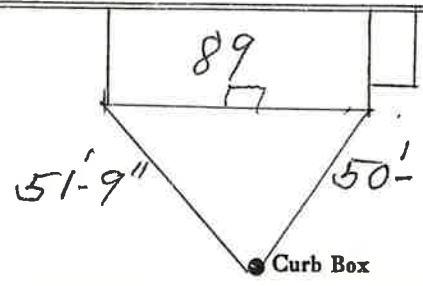

Main Elev. of
Main at tap _____

Gate at • • Gate at

● Curb Box