


LABOR AND MATERIALS

1	Copper } Connection	3/4"	\$	_____
1	Lead } Cock Valve	3/4 in.	\$	_____
	Curb } T.G. & V.		\$	_____
1	Service box { Short 3-1/2 x 4-1/2		\$	_____
	Old returned { Short 4-1/2 x 5-1/2		\$	_____
7	Ft. 3/4 in. { Copper		\$	_____
		} Pipe at	\$	_____
	Nipples	_____ in. at	\$	_____
	Bushings	_____ to _____ in. at	\$	_____
	Red'g		\$	_____
	Inc'g		\$	_____
	Union	_____ in. at	\$	_____
	Meter	_____ in. at	\$	_____
	Compound Joints at		\$	_____
	Maintenance Foreman		\$	_____
	Hrs. Water Maint. Man - 1 at		\$	_____
	Hrs. Water Maint. Man - 2 at		\$	_____
	Hrs. Garage Foreman	_____ at	\$	_____
	Hrs. Labor	_____ at	\$	_____
	Hrs. Compressor at		\$	_____
	Trucking		\$	_____
	Pav't Patch		\$	_____
			\$	_____
			\$	_____
GRANT St. Pt. Ave. No. 92
 Name of Owner _____

Labor and Mat'l. Report 19 35, Oct. 7

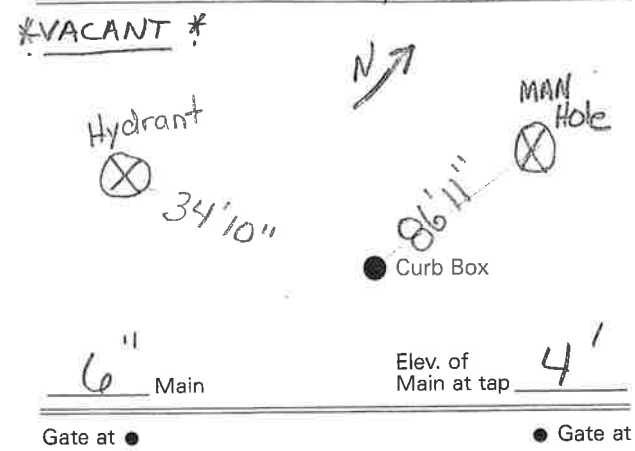

LOT TAP

● Curb Box