

LABOR AND MATERIALS


1	Copper	Connection	1"	\$	4.25
	Lead	Cock	1" stop +	\$	5.25
1	Curb	Valve	1" in. Waste	\$	
		T.S. & V.	cap. to Cop.		
1	Service box	Short 3 1/2 x 4 1/2		\$	4.69
	Old returned	Long 4 1/2 x 5 1/2		\$	
		Buff or Rdway		\$	
9	Ft. 1 in.	Copper	Pipe at 56	\$	5.04
		GI			
	Nipples	in. at		\$	
	Bushings	to in. at		\$	
	Red'g			\$	
	Inc'g	Coupl'gs to in. at		\$	
	Union	in. at		\$	
	Meter	in. at		\$	
	Lead Joints	at		\$	
	Compound Joints	at		\$	
	Maintenance Foreman			\$	15.00
	Hrs. Water Maint. Man-1	at		\$	4.96
4	Hrs. Water Maint. Man-2	at 1.24		\$	3.18
2	Hrs. Garage Foreman	at 1.59		\$	12.43
11	Hrs. Labor	at 1.13		\$	3.00
2	Hrs. Compressor at	4.50		\$	.88
	Compensation Ins. at \$	4.29 per C		\$	1.50
	Trucking			\$	6.72
	Pav't Patch			\$	
	O'head			\$	
				\$	51.85

Grant

St. \_\_\_\_\_  
Pl. \_\_\_\_\_  
Ave. No. 98

Name of Owner High School Rec. Field  
Board of Education

Labor and Mat'l. Report July 7 1955

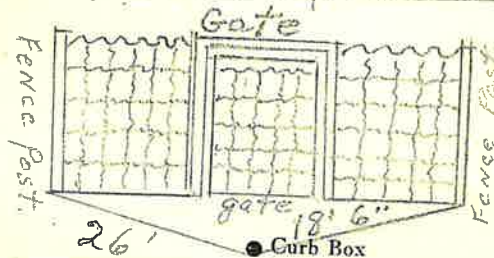

6" Main

Elev. of Main at tap 4'

Gate at •

• Gate at

• Curb Box

1" Tap for  
Ball Field  
on Grant Ave.