


LABOR AND MATERIALS

- 1 Copper } Connection 3/4" \$ _____
- 1 Curb } Cock } 3/4 in. \$ _____
- 1 Service box } Short 3-1/2 x 4-1/2 } \$ _____
- Old returned } long 1-1/2 x 5-1/2 }
- 28 Ft. 3/4 in. } Copper } Pipe at _____ \$ _____
- _____ Nipples _____ in. at _____ \$ _____
- _____ Bushings _____ to _____ in. at _____ \$ _____
- _____ Red'g _____
- _____ Inc'g _____
- _____ Union _____ in. at _____ \$ _____
- _____ Meter _____ in. at _____ \$ _____
- _____ Compound Joints at _____ \$ _____
- _____ Maintenance Foreman _____ \$ _____
- _____ Hrs. Water Maint. Man - 1 at _____ \$ _____
- _____ Hrs. Water Maint. Man - 2 at _____ \$ _____
- _____ Hrs. Garage Foreman _____ at _____ \$ _____
- _____ Hrs. Labor _____ at _____ \$ _____
- _____ Hrs. Compressor at _____ \$ _____
- _____ Trucking _____ \$ _____
- _____ Pav't Patch _____ \$ _____
- _____ \$ _____
- _____ \$ _____
GRANT Ave. No. 109
Name of Owner _____

Labor and Mat'l. Report 1935, Oct. 28
* VACANT LOT # #111 #107

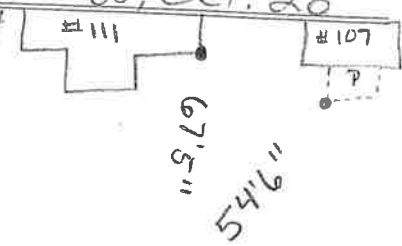

● Curb Box

6 Main Elev. of Main at tap 4 1/2

Gate at ● Gate at ●

● Curb Box

LOT TAP