


## LABOR AND MATERIALS

Copper } Connection _____	\$ _____
Lead } _____	\$ _____
Curb } Cock _____	\$ _____
} Valve _____	\$ _____
} T. S. & V. _____	\$ _____
Service box { Short 3½ x 4½ } _____	\$ _____
Old returned { Long 4½ x 5½ } _____	\$ _____
} Buff or Rdway _____	\$ _____
107 Ft. <sup>10"</sup> <del>45/4</del> <sup>3/4</sup> in. { Copper } Pipe at _____	\$ _____
} C.I. _____	\$ _____
} C.I. _____	\$ _____
Nipples _____ in. at _____	\$ _____
Bushings _____ to _____ in. at _____	\$ _____
Red'g } _____	\$ _____
Inc'g } Coupl'gs _____ to _____ in. at _____	\$ _____
Union _____ in. at _____	\$ _____
Meter _____ in. at _____	\$ _____
Lead Joints at _____	\$ _____
Compound Joints at _____	\$ _____
Maintenance Foreman _____	\$ _____
Hrs. Water Maint. Man—1 at _____	\$ _____
Hrs. Water Maint. Man—2 at _____	\$ _____
Hrs. Garage Foreman _____ at _____	\$ _____
Hrs. Labor— _____ at _____	\$ _____
Hrs. Compressor at _____	\$ _____
Compensation Ins. at \$ _____ per C _____	\$ _____
Trucking _____	\$ _____
Pav't Patch _____	\$ _____
_____	\$ _____
_____	\$ _____
_____	\$ _____
O'head _____	\$ _____
_____	\$ _____

St. \_\_\_\_\_  
Pl. \_\_\_\_\_  
Ave. No. 12

GRAYES  
Name of Owner \_\_\_\_\_  
Carol & Betty May

Labor and Mat'l. Report MARCH 22 1983

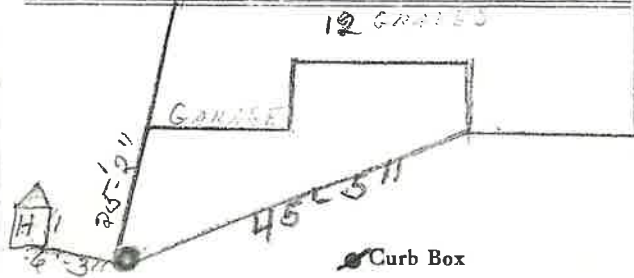

\_\_\_\_\_ Main Elev. of Main at tap \_\_\_\_\_

Gate at • • Gate at \_\_\_\_\_

• Curb Box