


LABOR AND MATERIALS

1	Copper Lead } Connection	3/4"	\$
1	Curb } Cock Valve } T.S. & V. }	3/4" in.	\$
1	Service box Old returned	{ Short 3-1/2 x 4-1/2 } { Long 4-1/2 x 5-1/2 }	\$
32	Ft. 3/4 in. } Copper }	Pipe at	\$
	Nipples	in. at	\$
	Bushings	to in. at	\$
	Red'g		
	Inc'g		
	Union	in. at	\$
	Meter	in. at	\$
			\$
	Compound Joints at		\$
	Maintenance Foreman		\$
	Hrs. Water Maint. Man - 1 at		\$
	Hrs. Water Maint. Man - 2 at		\$
	Hrs. Garage Foreman at		\$
	Hrs. Labor at		\$
	Hrs. Compressor at		\$
			\$
	Trucking		\$
	Pav't Patch		\$
			\$
			\$
St. GLEN Ave. No. 416
 Name of Owner _____

Labor and Mat'l. Report 1929, Nov. 1

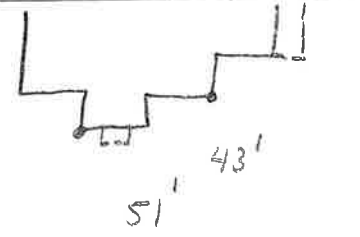

● Curb Box
 12" Main
 Elev. of Main at tap 4'
 Gate at ● ● Gate at

● Curb Box
 OLD TAP SHUT OFF

REMEASURED 1988