




# LABOR AND MATERIALS

1	Copper Lead } Connection	G X 4 TAPING SLEEVE	\$	
1	Curb } Cook Valve } T.S. & V. }	4 in.	\$	
1	GATE Service box } Old returned }	Short 3-1/2 x 4-1/2 } Long 4-1/2 x 5-1/2 }	\$	
20	Ft. 4 in. } Copper G.I. C.I. }	Pipe at	\$	
	Nipples	in. at	\$	
	Bushings	to in. at	\$	
	Red'g		\$	
	Inc'g		\$	
	Union	in. at	\$	
	Meter	in. at	\$	
			\$	
	Compound Joints at		\$	
	Maintenance Foreman		\$	
	Hrs. Water Maint. Man - 1 at		\$	
	Hrs. Water Maint. Man - 2 at		\$	
	Hrs. Garage Foreman	at	\$	
	Hrs. Labor	at	\$	
	Hrs. Compressor at		\$	
			\$	
	Trucking		\$	
	Pav't Patch		\$	
			\$	
			\$	
GLEN  
GOODWIN

St. 421-433  
Ave. No. 7

Name of Owner  
FORMER JR. HIGH SCHOOL

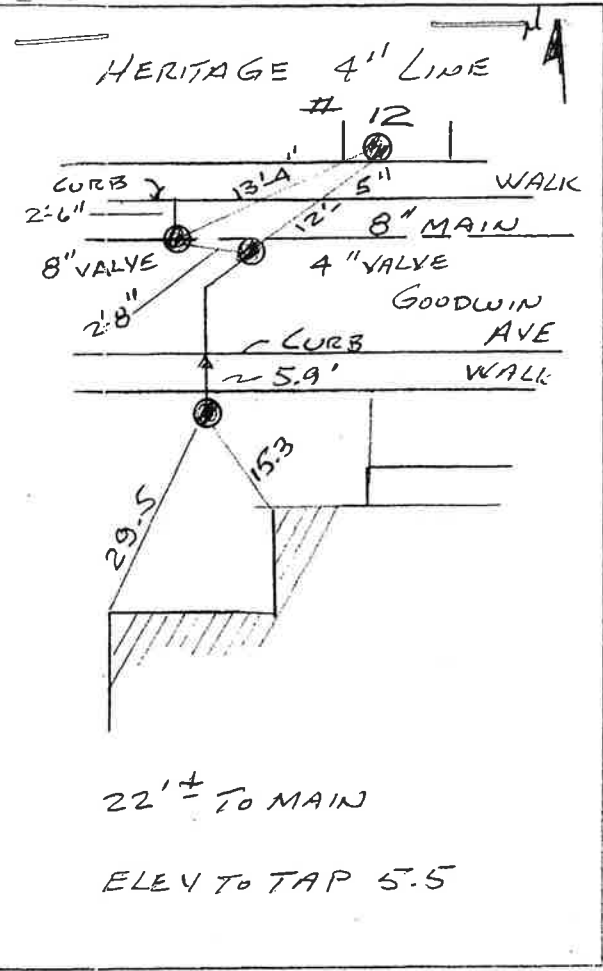

### LABOR AND MATERIALS

1	Copper Lead	Connection	1 1/2"	\$
1	Curb	Cock Valve T.S. & V.	2 in. Oriseal	\$
1	Service box Old returned	Short 3 1/2 x 4 1/2 Long 4 1/2 x 5 1/2 Buff or Rdway	Oriseal curb box	\$
21	Ft. 2 in.	Copper C.I. C.I.	Pipe at	\$
2	Nipples	Brass 1-6" long	in. at	\$
	Bushings	to	in. at	\$
1	Red'g Inc'g	Coupl'gs 2" to 2"	in. at	\$
1	Union	Brass in. at 2" Elbow		\$
1	Meter	Female in. at 2" Adaptor		\$
	Lead Joints at			\$
	Compound Joints at			\$
	Maintenance Foreman			\$
	Hrs. Water Maint. Man-1 at			\$
	Hrs. Water Maint. Man-2 at			\$
	Hrs. Garage Foreman at			\$
	Hrs. Labor at			\$
	Hrs. Compressor at			\$
	Compensation Ins. at \$	per C		\$
	Trucking			\$
	Pav't Patch			\$
	Tap by Larsen & Co			\$
				\$
				\$
	O'head			\$

9-14-65

Glen

St. Pl. 421-433  
Ave. No.

Name of Owner

Turline High School

