


LABOR AND MATERIALS

| | | | | |
|-----------------------|-----------------------|-----------------------|----------|--------------|
| Copper | } Connection | _____ | \$ _____ | |
| Lead | | | | |
| Curb | } Cock | } _____ in. | \$ _____ | |
| | | | | } Valve |
| | | | | |
| Service box | } Short 3½ x 4½ | } | \$ _____ | |
| Old returned | | | | Long 4½ x 5½ |
| 30 Ft. | } Copper | } Pipe at _____ | \$ _____ | |
| 1 in. | | | | } G. I. |
| | | | | |
| Nipples | in. at _____ | \$ _____ | | |
| Bushings | to _____ in. at _____ | \$ _____ | | |
| Red'g | } Coupl'gs | to _____ in. at _____ | \$ _____ | |
| Inc'g | | | | |
| Union | in. at _____ | \$ _____ | | |
| Meter | in. at _____ | \$ _____ | | |
| Compound Joints | at _____ | \$ _____ | | |
| Maintenance Foreman | _____ | \$ _____ | | |
| Hrs. Water Maint. Man | —1 at _____ | \$ _____ | | |
| Hrs. Water Maint. Man | —2 at _____ | \$ _____ | | |
| Hrs. Garage Foreman | at _____ | \$ _____ | | |
| Hrs. Labor | at _____ | \$ _____ | | |
| Hrs. Compressor | at _____ | \$ _____ | | |
| Trucking | _____ | \$ _____ | | |
| Pav't Patch | _____ | \$ _____ | | |
| | _____ | \$ _____ | | |
| | _____ | \$ _____ | | |
| | _____ | \$ _____ | | |
| | _____ | \$ _____ | | |

St. _____
Pl. _____
Ave. No. 407

Name of Owner _____

Labor and Mat'l. Report _____ 19

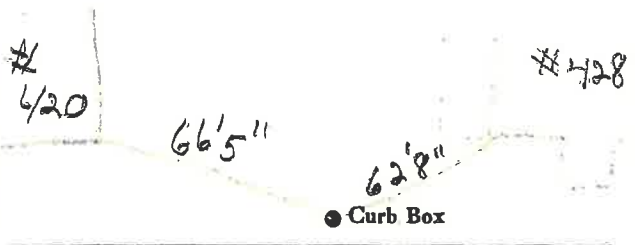

● Curb Box

Main _____ Elev. of Main at tap _____

Gate at ● _____ ● Gate at _____

● Curb Box