

LABOR AND MATERIALS


Copper	}	Connection		\$		
Lead						
Curb	}	Cock	in.	\$		
		Valve				
		T. S. & V.				
Service box	}	Short 3½ x 4½				
Old returned		Long 4½ x 5½				
		Buff or Rdway			\$	
36 Ft. ^{3/4} in.	}	Copper	Pipe at			
		C.I.			\$	
		C.I.				
Nipples		in. at		\$		
Bushings		to in. at		\$		
Red'g	}	Coupl'gs	to in. at			
Inc'g					\$	
Union		in. at		\$		
Meter		in. at		\$		
Lead Joints at				\$		
Compound Joints at				\$		
Maintenance Foreman				\$		
Hrs. Water Maint. Man—1 at				\$		
Hrs. Water Maint. Man—2 at				\$		
Hrs. Garage Foreman at				\$		
Hrs. Labor— at				\$		
Hrs. Compressor at				\$		
Compensation Ins. at \$		per C		\$		
Trucking				\$		
Pav't Patch				\$		
				\$		
				\$		
O'head				\$		
				\$		

St.
No. 442

GLEN
Name of Owner

SEPT. 1982

Labor and Mat'l. Report

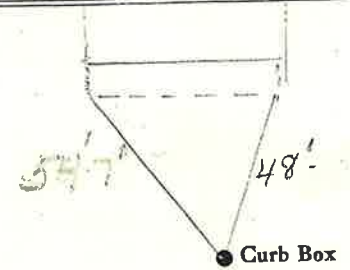

	Main	Elev. of Main at tap
Gate at ●		● Gate at
		● Curb Box