


LABOR AND MATERIALS

1	Copper Lead	Connection	3/4"	\$	
1	Curb	Cock Valve T.S. & V.	1" in.	\$	
1	Service box	Short 3-1/2 x 4-1/2		\$	
	Old returned	Long 4-1/2 x 5-1/2		\$	
8	Ft.	1" in. Copper G.I. Pipe		\$	
	Nipples		in. at	\$	
	Bushings		to in. at	\$	
	Red'g				
	Inc'g				
	Union		in. at	\$	
	Meter		in. at	\$	
	Compound Joints		at	\$	
	Maintenance Foreman			\$	
	Hrs. Water Maint. Man - 1		at	\$	
	Hrs. Water Maint. Man - 2		at	\$	
	Hrs. Garage Foreman		at	\$	
	Hrs. Labor		at	\$	
	Hrs. Compressor		at	\$	
	Trucking			\$	
	Pav't Patch			\$	
				\$	
				\$	
St. GLEN
 Ave. No. 470
 Name of Owner _____

Labor and Mat'l. Report 1924, APR. 3

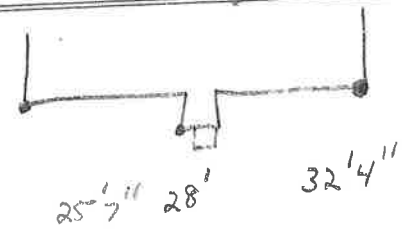

● Curb Box
HARRISON AVE
 4" Main
 Elev. of Main at tap 5'
 Gate at ● ● Gate at
TAP ON HARRISON
 ● Curb Box