


LABOR AND MATERIALS

1	Copper Lead	Connection	$\frac{3}{4}$	\$	
1	Curb	Cock Valve T.S. & V.	1" in.	\$	
1	Service box	Short 3-1/2 x 4-1/2		\$	
	Old returned	Long 4-1/2 x 5-1/2		\$	
35	Ft.	1" in.	Copper G.I. Pipe	at	\$
	Nipples		in.	at	\$
	Bushings		to	in.	at \$
	Red'g				
	Inc'g				
	Union		in.	at	\$
	Meter		in.	at	\$
					\$
	Compound Joints	at			\$
	Maintenance Foreman				\$
	Hrs. Water Maint. Man - 1	at			\$
	Hrs. Water Maint. Man - 2	at			\$
	Hrs. Garage Foreman	at			\$
	Hrs. Labor	at			\$
	Hrs. Compressor	at			\$
					\$
	Trucking				\$
	Pav't Patch				\$
					\$
					\$
St. GLEN No. 474 AB
 Name of Owner _____

Labor and Mat'l. Report 1924, APR. 1

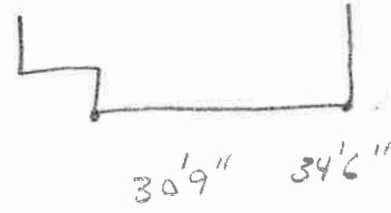

● Curb Box

16" Main Elev. of Main at tap 5'

Gate at ● ● Gate at

TAX ID # 302.16-9-3

● Curb Box