

LABOR AND MATERIALS


1	Copper	Connection	3/4	\$	2.87
1	Lead	Cock Valve T.S. & V.	3/4 in.	\$	3.62
1	Service box	Short 3 1/2 x 4 1/2		\$	4.68
	Old returned	Long 4 1/2 x 5 1/2		\$	
9	Ft.	Copper	Pipe at 32	\$	2.88
		G.I.		\$	
		G.I.		\$	
	Nipples	in. at		\$	
	Bushings	to in. at		\$	
	Red'g Inc'g	Coupl'gs to in. at		\$	
	Union	in. at		\$	
	Meter	in. at		\$	
	Lead Joints at			\$	
	Compound Joints at			\$	
	Hrs. Water Maint. Man-1 at			\$	
4	Hrs. Water Maint. Man-2 at	1.02		\$	4.08
24	Hrs. Labor at	91		\$	21.84
	Hrs. Labor at			\$	
	Hrs. Compressor at			\$	
	Compensation Ins. at	\$ 2.18 per C.		\$.57
	Trucking			\$	3.00
	Pav't Patch			\$	10.25
	Tap by McGinnis			\$	
	O'head			\$	
				\$	52.79

1777 Tap at Lincoln Ave

Glen St St. Pl. Ave. No. 500

Name of Owner Dr. Howard

Labor and Mat'l. Report Nov 10 19 49

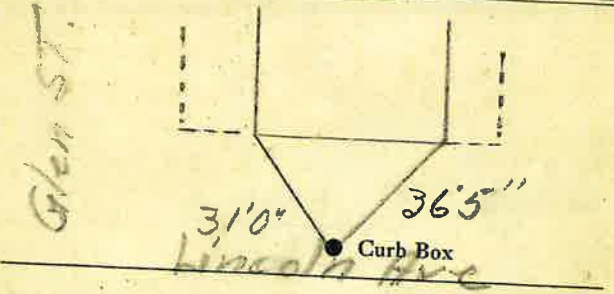

14" Main Elev. of Main at tap 5
Gate at ● Gate at ●

● Curb Box