


LABOR AND MATERIALS

<u>1</u>	Copper } Connection <u>3/4</u>	\$ _____
<u>1</u>	Lead } Cock Valve } <u>3/4</u> in.	\$ _____
<u>1</u>	Curb } T.S. & V. }	\$ _____
<u>1</u>	Service box { Short 3-1/2 x 4-1/2 }	\$ _____
	Old returned { Long 4-1/2 x 5-1/2 }	\$ _____
<u>37</u>	Ft. <u>3/4</u> in. { Copper } Pipe at	\$ _____
	Nipples _____ in. at	\$ _____
	Bushings _____ to _____ in. at	\$ _____
	Red'g _____	\$ _____
	Inc'g _____	\$ _____
	Union _____ in. at	\$ _____
	Meter _____ in. at	\$ _____
	_____	\$ _____
	Compound Joints at	\$ _____
	Maintenance Foreman _____	\$ _____
	Hrs. Water Maint. Man - 1 at	\$ _____
	Hrs. Water Maint. Man - 2 at	\$ _____
	Hrs. Garage Foreman _____ at	\$ _____
	Hrs. Labor _____ at	\$ _____
	Hrs. Compressor at	\$ _____
	_____	\$ _____
	Trucking _____	\$ _____
	Pav't Patch _____	\$ _____
	_____	\$ _____
	_____	\$ _____
Glen St. No. 510

Name of Owner G. H. King

Labor and Mat'l. Report 19 37, May 3

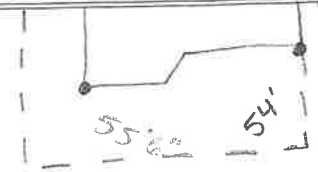

● Curb Box

12 Main Elev. of Main at tap 5

Gate at ● Gate at ●

● Curb Box

Old Shut off