

# LABOR AND MATERIALS

1	Gepper } Connection	1"	\$
1	Lead } Cock		
1	Curb } Valve	1 1/4 in.	\$
		T.S. & V.	
1	Service box	{ Short 3-1/2 x 4-1/2 }	\$
	Old returned	{ Long 4-1/2 x 5-1/2 }	\$
32	Ft. 1 1/4 in. { Gepper } Pipe at		\$
		{ G.I. }	
		{ 3/4" }	
	Nipples	in. at	\$
	Bushings	to in. at	\$
	Red'g		
	Inc'g		
	Union	in. at	\$
	Meter	in. at	\$
			\$
	Compound Joints at		\$
	Maintenance Foreman		\$
	Hrs. Water Maint. Man - 1 at		\$
	Hrs. Water Maint. Man - 2 at		\$
	Hrs. Garage Foreman	at	\$
	Hrs. Labor	at	\$
	Hrs. Compressor at		\$
			\$
	Trucking		\$
	Pav't Patch		\$
			\$
			\$
Glen


St.

Ave. No.

528

Name of Owner

Labor and Mat'l. Report 19 24, Sept. 11

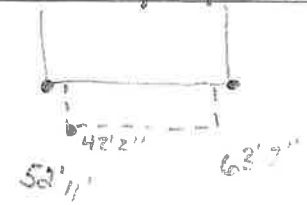

● Curb Box

12 Main

Elev. of Main at tap 4

Gate at ●

● Gate at

● Curb Box

PAVEMENT