

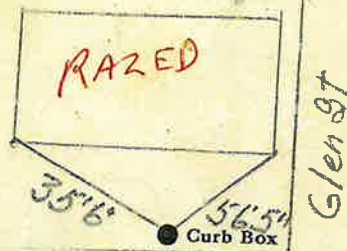
56

St.  
Pl. Glen St  
Ave. No 75-79

Name of Owner

Sy W Furniture Co.

Labor and Mat'l. Report

May 17 19 49

4 Main

Elev. of  
Main at tap 5

Gate at ●

● Gate at

● Curb Box

LSM-5C 5 1B-48

Top on Berry St

## LABOR AND MATERIALS

1	Copper	Connection	$\frac{3}{4}$		\$	2.94
1	Lead	Cock				
1	Curb	Valve	$\frac{3}{4}$	in.	\$	3.71
		T. S. & V.				
1	Service box	Short	$3\frac{1}{2} \times 4\frac{1}{2}$			
	Old returned	Long	$4\frac{1}{2} \times 5\frac{1}{2}$			
		Buffer Rdway			\$	5.90
23	Ft.	$\frac{3}{4}$	in.	Copper	Pipe at	30 \$ 6.90
				G.I.		
				C.I.		
	Nipples	in.	at		\$	
	Bushings	to	in.	at	\$	
	Red'g					
	Inc'g	Coupl'gs	to	in.	at	\$
	Union	in.	at		\$	
	Meter	in.	at		\$	
	Lead Joints	at			\$	
	Compound Joints	at			\$	
2	Hrs. Water Maint. Man-1	at	1.01		\$	2.02
7	Hrs. Water Maint. Man-2	at	9.1		\$	6.37
11	Hrs. Labor	at	8.0		\$	8.80
	Hrs. Labor	at			\$	
1	Hrs. Compressor	at			\$	1.20
	Compensation Ins.	at \$		per C	\$	38
	Trucking				\$	1.00
	Pav't Patch				\$	15.30
	Tap by Warsinski				\$	
	O'head				\$	
					\$	54.52

Nov. 3-70

Shot off at  
curb & razed.

To be dug up  
at main on  
Berry St. or  
Abandoned.