


## LABOR AND MATERIALS

Copper	Lead	} Connection			\$
Curb	Cock Valve	} T.S. & V. }	in.		\$
Service box	Old returned		{ Short 3-1/2 x 4-1/2		
		{ Long 4-1/2 x 5-1/2			\$
11	Ft.	3/4 in.	{ Copper	Pipe at	\$
			{		\$
	Nipples		in.	at	\$
	Bushings		to	in. at	\$
	Red'g				\$
	Inc'g				\$
	Union		in.	at	\$
	Meter		in.	at	\$
					\$
	Compound Joints at				\$
	Maintenance Foreman				\$
	Hrs. Water Maint. Man - 1 at				\$
	Hrs. Water Maint. Man - 2 at				\$
	Hrs. Garage Foreman		at		\$
	Hrs. Labor		at		\$
	Hrs. Compressor at				\$
					\$
	Trucking				\$
	Pav't Patch				\$
					\$
					\$
St. Glen  
 Ave. No. 541

Name of Owner \_\_\_\_\_

Labor and Mat'l. Report 19 39, Aug. 23

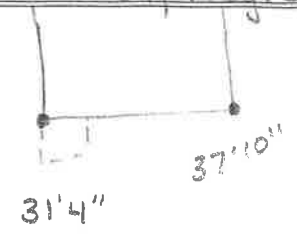

● Curb Box

Main Elev. of Main at tap \_\_\_\_\_

Gate at ● ● Gate at

● Curb Box

renewed 4/21/82  
 "same measurements"