


# LABOR AND MATERIALS

1	Copper Lead	Connection	3/4"	\$	_____
1	Curb	Cock Valve T.S. & V.	3/4 in.	\$	_____
1	Service box	Short 3-1/2 x 4-1/2		\$	_____
	Old returned	Long 4-1/2 x 5-1/2		\$	_____
10	Ft. 3/4 in.	Copper Pipe	at	\$	_____
	Nipples		in. at	\$	_____
	Bushings		to _____ in. at	\$	_____
	Red'g				_____
	Inc'g				_____
	Union		in. at	\$	_____
	Meter		in. at	\$	_____
				\$	_____
	Compound Joints	at		\$	_____
	Maintenance Foreman			\$	_____
	Hrs. Water Maint. Man - 1	at		\$	_____
	Hrs. Water Maint. Man - 2	at		\$	_____
	Hrs. Garage Foreman	at		\$	_____
	Hrs. Labor	at		\$	_____
	Hrs. Compressor	at		\$	_____
				\$	_____
	Trucking			\$	_____
	Pav't Patch			\$	_____
				\$	_____
				\$	_____
Glen St. Ave. No. 553

Name of Owner Grossman

Labor and Mat'l. Report 19 52, Dec. 18

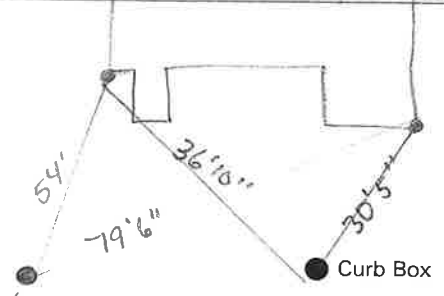

12" Main Elev. of Main at tap 5'

Gate at ● Gate at ●

● Curb Box