


LABOR AND MATERIALS

1	Copper } Connection	3/4"		\$	
	Lead				
1	Curb } Cock	} 3/4" in.		\$	
	Valve				
	T.S. & V.				
1	Service box	{ Short 3-1/2 x 4-1/2		\$	
	Old returned	{ Long 4-1/2 x 6-1/2			
4	Ft. 3/4 in. { Copper	} Pipe at		\$	
			{ Gt.		
			{ Gt.		
	Nipples	_____ in. at _____		\$	
	Bushings	_____ to _____ in. at _____		\$	
	Red'g				
	Inc'g				
	Union	_____ in. at _____		\$	
	Meter	_____ in. at _____		\$	
				\$	
	Compound Joints	at _____		\$	
	Maintenance Foreman	_____		\$	
	Hrs. Water Maint. Man - 1	at _____		\$	
	Hrs. Water Maint. Man - 2	at _____		\$	
	Hrs. Garage Foreman	_____ at _____		\$	
	Hrs. Labor	_____ at _____		\$	
	Hrs. Compressor	at _____		\$	
				\$	
	Trucking	_____		\$	
	Pav't Patch	_____		\$	
				\$	
				\$	
St. Glen
 Ave. No. 625

Name of Owner Boyle

Labor and Mat'l. Report 1928, July 25

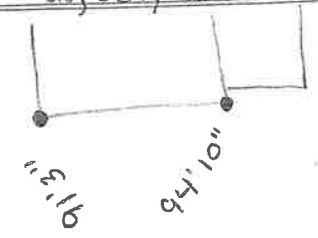

12" Main Elev. of Main at tap 4

Gate at ● ● Gate at

● Curb Box