

LABOR AND MATERIALS

1	Copper	} Connection	2"		\$
	Lead				
1	Curb	} Cock	2 in. Oriseal		\$
		Valve			
		T. S. & V.			
1	Service box	} Oriseal Curb box	Short 3 1/2 x 4 1/2		\$
	Old returned		Long 4 1/2 x 5 1/2		
			Buff or Rdway		
6	Ft. 2 in.	} Copper	} Pipe at		\$
		G.I.			
		C.I.			
	Nipples	in. at			\$
	Bushings	to in. at			\$
	Red'g	} Coupl'gs	to in. at		\$
	Inc'g				
	Union	in. at			\$
	Meter	in. at			\$
	Lead Joints at				\$
	Compound Joints at				\$
	Maintenance Foreman				\$
	Hrs. Water Maint. Man-1 at				\$
	Hrs. Water Maint. Man-2 at				\$
	Hrs. Garage Foreman at				\$
	Hrs. Labor at				\$
	Hrs. Compressor at				\$
	Compensation Ins. at \$	per C			\$
	Trucking				\$
	Pav't Patch				\$
	Tap by Lareau & Co.				\$
					\$
					\$
	O'head				\$
					\$

6-24-68

Crandall Park

Glen


St.
Pl.
Ave. No.

Name of Owner

New Y.M.C.A. Bldg.

Labor and Mat'l. Report

June 24 1968

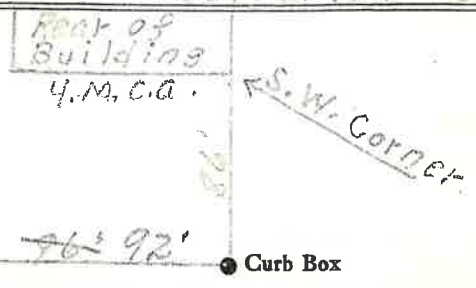

20" Main

Elev. of Main at tap 5'

Gate at ●

● Gate at

● Curb Box