

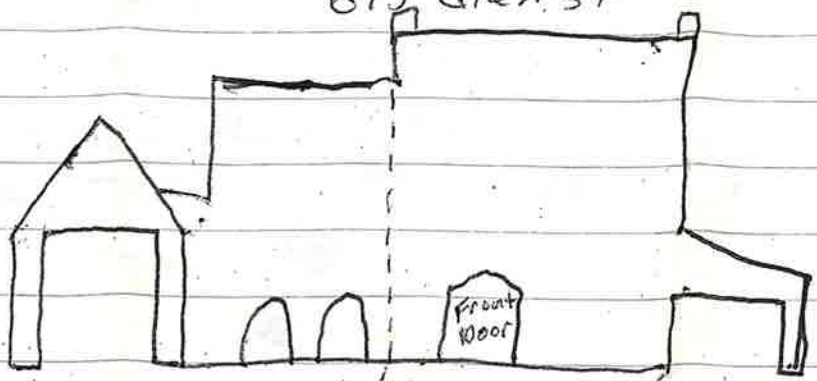


2" Water Line That Feeds In front of YMCA
615 Glen St

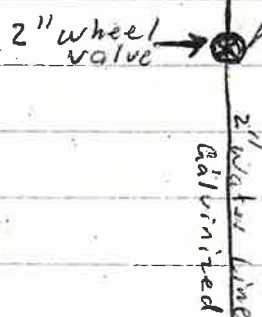


110' 5"
142' 4"

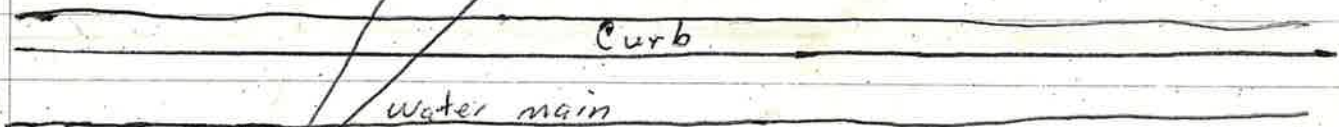


North

South

0' 0" CURB STOP
3/4" OFF
↓ OFF

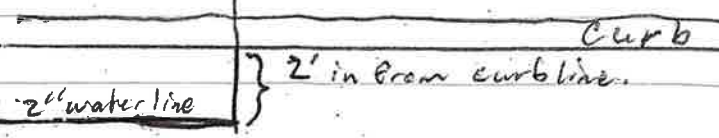

Curb

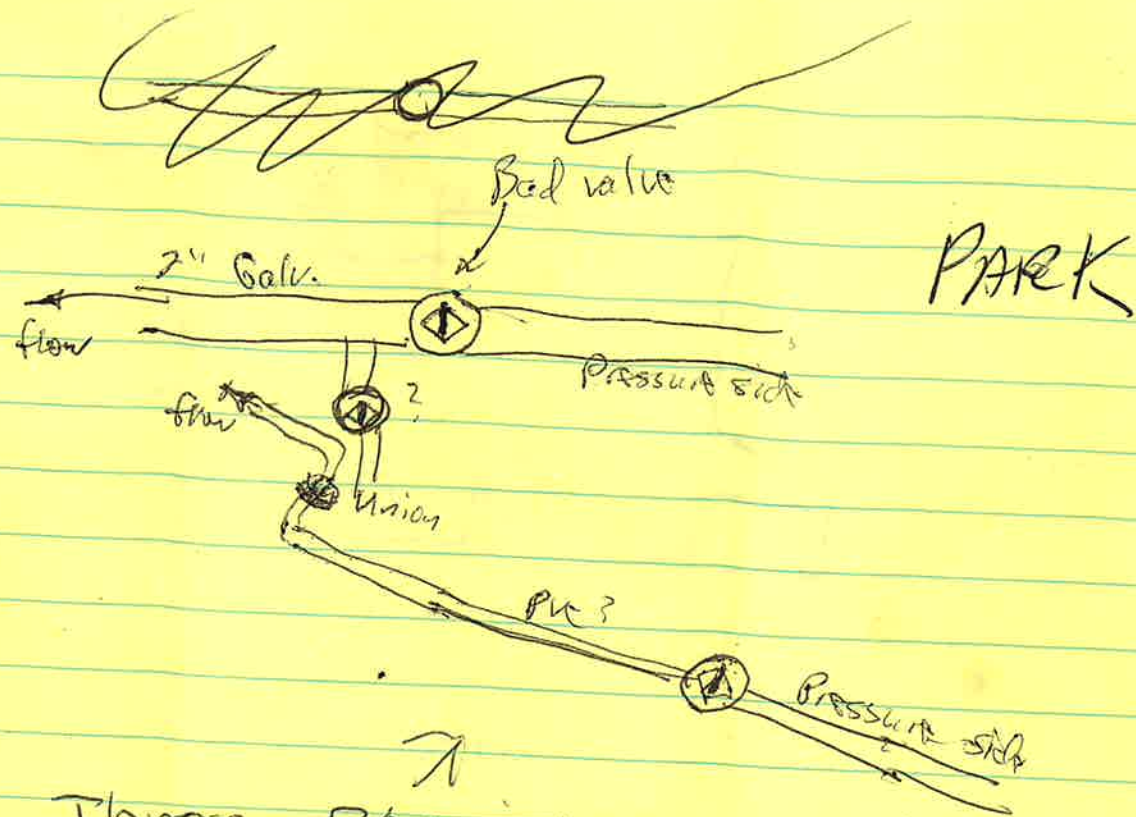

Three Box in this part