


Memo.
 Top for Fessio Station
 Glen & Oakland.
 Tap on Oakland

#38 Glen St

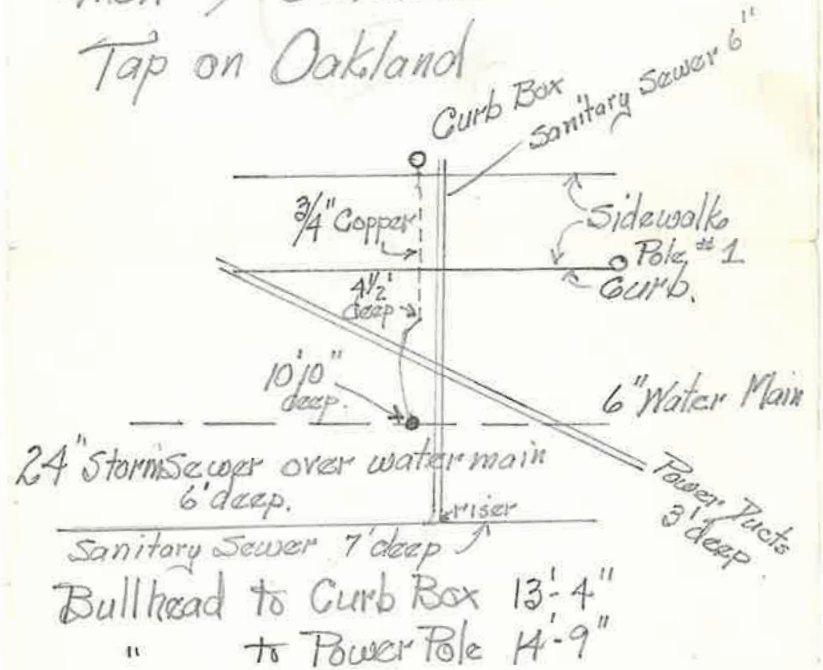

"Where the Promise is Fulfilled"

PRINTING DEPARTMENT, GLENS FALLS POST COMPANY
 GUY J. DAMIANO, Manager TELEPHONE: RX 2-3131

38

Glen St.

Memo