


Labor and Materials

1	Copper	Connection	2"	\$ 27.80
1	Curb	Cock Valve	2" in.	\$ 15.40
1	Service Box	Short 3/4" x 1/2" Long 1 1/2" x 5/8" Bulk or Rdway	Small	\$ 5.-
27	Ft.	Copper Galv. Iron Cast Iron	Pipe at	\$ 24.30
	Nipples	in. at		\$
	Bushings	to in. at		\$
	Red'g Inc'g	Couplings	to in. at	\$
	Union	in. at		\$
	Meter	in. at		\$
	Lbs. Br. Stone	at		\$
	Lbs. Sand	at		\$
	Bags Cement	at		\$
	Paving Brick	Mack Red Asphalt	at	\$
	Lead Joints	at		\$
	Leadite Joints	at		\$
12	Hrs.	Foreman	at	\$ 7.50
24	Hrs.	Common Labor	at	\$ 10.80
	Hrs.	Common Labor	at	\$
	Hrs.	Mason	at	\$
	Hrs.	Mason's Helper	at	\$
	Hrs.	Compressor	at	\$
	Compensation	Ins		\$ 52
	Trucking			\$ 2.00
	Builders' Use of Water	Patch		\$ 25.-

Total \$ 114.02

157
2" Tap Crandall Free Library

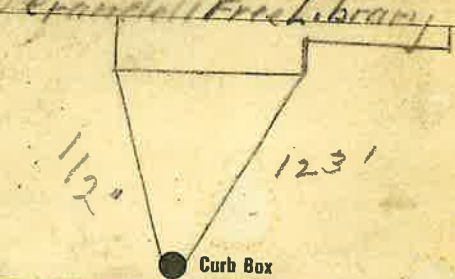

Glen St. End

12" Main

Elev of Main at tap 5 1/2

Gate at ●

● Gate at

● Curb Box

This Tap on
Glen St.
12" main
Crandall Library
City Park,