


Name of Owner

476 Glen

St. Pl. Ave. No.

Labor and Mat'l. Report 19

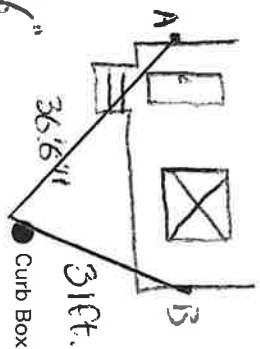

A-36'6"

B-31'

Main

Elev. of Main at tap

Gate at ●

● Gate at

● Curb Box