


# LABOR AND MATERIALS

1	Copper	} Connection	1"	\$
1	Lead			\$
1	Curb	} Cock Valve T.G. & V.	1" ORISEAL in.	\$
1	Service box		{ Short 3-1/2 x 1-1/2 Old returned Long 4-1/2 x 5-1/2 }	
47	Ft. 1" in.	{ Copper		Pipe at
	Nipples		in. at	\$
	Bushings		to in. at	\$
	Red'g			
	Inc'g			
	Union		in. at	\$
	Meter		in. at	\$
	Compound Joints at			\$
	Maintenance Foreman			\$
	Hrs. Water Maint. Man - 1 at			\$
	Hrs. Water Maint. Man - 2 at			\$
	Hrs. Garage Foreman		at	\$
	Hrs. Labor		at	\$
	Hrs. Compressor at			\$
	Trucking			\$
	Pav't Patch			\$
				\$
				\$
St. GLEN  
 Ave. No. 200-204  
 Name of Owner \_\_\_\_\_

Labor and Mat'l. Report 19 29, JUNE 28

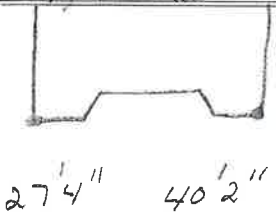

● Curb Box  
 : IN STREET

12" Main  
 Elev. of Main at tap 5 1/2'

Gate at ● Gate at ●

● Curb Box


# LABOR AND MATERIALS

1 Copper } Connection SPLIT TEE \$ 12x6"  
 1 Lead }  
 1 Gurb. Valve } GATE } in. \$  
 1 Service box { Short 3-1/2 x 4-1/2 } GATE BOX \$  
 Old returned { Long 4-1/2 x 5-1/2 } \$  
 37 Ft. 6" in. { Copper } Pipe at \$  
 { G.I. }  
 { Gal. }  
 Nipples in. at 1-6x8 OFFSET \$  
 Bushings to in. at \$  
 Red'g \$  
 Inc'g \$  
 Union in. at \$  
 Meter in. at \$  
 Compound Joints at \$  
 Maintenance Foreman \$  
 Hrs. Water Maint. Man - 1 at \$  
 Hrs. Water Maint. Man - 2 at \$  
 Hrs. Garage Foreman at \$  
 Hrs. Labor at \$  
 Hrs. Compressor at \$  
 Trucking \$  
 Pav't Patch \$  
 \$  
 \$  
St. GLEN  
 Ave. No. 200-204

Name of Owner  
MERKEL & GELMAN

Labor and Mat'l. Report 1924, DEC. 18

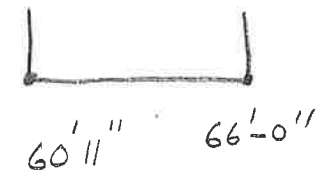

● ~~Gate~~ Box  
GATE

12" Main Elev. of Main at tap 4'

Gate at ● Gate at

● Curb Box