

# LABOR AND MATERIALS


1	Copper } Connection	1"	\$
1	Lead } Cock	1"	\$
1	Curb } Valve	1" in.	\$
1	Service box	{ Short 3-1/2 x 4-1/2 Old returned { Long 4-1/2 x 5-1/2	\$
39	Ft. 1" in. { Copper	Pipe at	\$
1	Nipples	1" in. at	\$
1	Bushings	to 1" in. at	\$
1	Red'g	1 1/4" to 1"	\$
	Inc'g		\$
	Union	in. at	\$
	Meter	in. at	\$
	Compound Joints at		\$
	Maintenance Foreman		\$
	Hrs. Water Maint. Man - 1 at		\$
	Hrs. Water Maint. Man - 2 at		\$
	Hrs. Garage Foreman at		\$
	Hrs. Labor at		\$
	Hrs. Compressor at		\$
	Trucking		\$
	Pav't Patch		\$
			\$
			\$
GLEN

St. Pt. Ave. No. 234-238

Name of Owner  
TAX ID # 302.20-28-11

Labor and Mat'l. Report 19 29, MAY 22

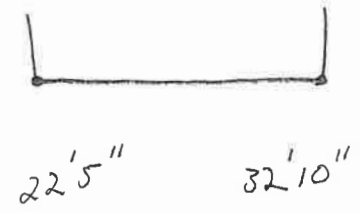

● Curb Box

12" Main

Elev. of Main at tap 5 1/2'

Gate at ●

● Gate at

● Curb Box

No. 101

# LABOR AND MATERIALS

Copper	} Connection		\$
Lead			
1	} Curb Valve T.S. & V.	6" in.	\$
1	} Service box	GATE BOX	\$
39'	} Ft. 6" in.	Copper C.I.	Pipe at \$
	Nipples	in. at	\$
	Bushings	to in. at	\$
	Red'g		
	Inc'g		
	Union	in. at	\$
	Meter	in. at	\$
			\$
	Compound Joints at		\$
	Maintenance Foreman		\$
	Hrs. Water Maint. Man - 1 at		\$
	Hrs. Water Maint. Man - 2 at		\$
	Hrs. Garage Foreman	at	\$
	Hrs. Labor	at	\$
	Hrs. Compressor at		\$
			\$
	Trucking		\$
	Pav't Patch		\$
			\$
			\$
			\$
			\$

St.

GLEN

Av. No. 234-238

Name of Owner

Labor and Mat'l. Report 19 29, JUNE 11



60'3" 63'7"

● Curb Box

12" Main

Elev. of Main at tap 4 1/2'

Gate at ●

● Gate at

● Curb Box