

**Labor and Materials**

1	Copper	Lead	Connection	1"	\$ 3.65
1	Curb	Cock Valve	T.S. & V.	1" in.	\$ 3.40
1	Service Box	Short 3/4x4 1/2	Long 1 1/2x5 1/2	Extra	\$ 1.75
49	Ft.	Copper	Galv. Iron	Pipe at	\$ 21.32
1	Nipples	1"	in. at		\$ .18
	Bushings		to	in. at	\$
1	Red'g	Inc'g	Couplings	1/4" to 1"	\$ .30
	Union		in. at		\$
	Meter		in. at		\$
	Lbs. Br. Stone	at			\$
	Lbs. Sand	at			\$
	Bags Cement	at			\$
	Paving Brick	Mack Red Asphalt	at		\$
	Lead Joints	at			\$
	Leadite Joints	at			\$
17	Hrs. Foreman	at			\$ 10.63
1	Hrs. Common Labor	at	Tapper		\$ .50
62	Hrs. Common Labor	at			\$ 25.19
	Hrs. Mason	at			\$
	Hrs. Mason's Helper	at			\$
	Hrs. Compressor	at			\$
	Compensation Ins.				\$ .96
	Trucking				\$ 2.00
	Builders' Use of Water	Patch			\$ 25.00
Total					\$ 94.85

**Labor and Material Report**

May 24 1929

1" tap at 172 1/2 St. at



252-270

172 1/2 St.

254

12" Main

Elev of Main at tap 5 ft

Gate at ●

● Gate at

Curb Box  
 This Tap Shut off  
 at Curb. Building  
 razed.

No 102

✓

### Labor and Materials

Copper	{	Connection.....	\$	
Lead	}			
1 Curb	{	Cock Valve		
		1" in	\$	3.38
1 Service Box	{	Short 3 1/2 x 4 1/2		
Old returned		Long 4 1/2 x 5 1/2	\$	1.75
		Buff. or Rdway		
2 Ft. 1" in.	{	Copper		
		Galv-iron	Pipe at 33	\$ 1.66
		Cast-iron		
Nipples		in. at	\$	
Bushings		to in. at	\$	
Red'g	{	Couplings.....	to in. at	\$
Inc'g	}			
Union		in. at	\$	
Meter		in. at	\$	
Lead Joints		at	\$	
Leadite Joints		at	\$	
Hrs. Foreman		at	\$	
Hrs. Chauffeur		at	\$	
Hrs. Tapper		at	\$	
Hrs. Labor		at	\$	
Hrs. Labor		at	\$	
Hrs. Compressor		at	\$	
Compensation Ins.			\$	
Trucking			\$	
Builders Use of Water			\$	
Patch			\$	9.-
			\$	
			\$	
			\$	
			\$	14.79

St. *252 270*  
 Pl. *168*  
 Ave. No. *168*

*Glen St*  
 Name of Owner *Report*  
*Casey and Bradley News Rm*

Labor and Mat'l. Report *June 9* 19*07*

*Leak Repair*  
*Montgomery*  
*Ward & Co.* *252-270*

*5.3' 4"* *15' 10"*

● Curb Box

*News Rm. Raked*

Main Elev. of Main at tap.....

Gate at ● *Shut off at curb* ● Gate at  
*and Curb box plugged with*  
*CEMENT.*

● Curb Box

*This is a one inch line,*  
*taken off Montgomery*  
*Ward & Co's 1 1/2" line*  
*at the curb.*



### LABOR AND MATERIALS

Copper	{	Connection	-----	\$	
Lead					
Curb	{	Cock	-----	\$	
		Valve	-----	\$	
		T. S. & V.	-----	\$	
Service Box	{	Short 3/2x4 1/2	-----	\$	
Old returned		Long 4 1/2x5 1/2	-----	\$	
		Buff. or Rdway	-----	\$	
Ft. -----	in.	{			
		Copper	-----	\$	
		Galv Iron	-----	\$	
		Cast Iron	-----	\$	
		Pipe at	-----	\$	
Nipples	-----	in. at	-----	\$	
Bushings	-----	to -----	in. at	-----	\$
Red'g	{	Couplings	-----	\$	
Inc'g		to -----	in. at	-----	\$
Union	-----	in. at	-----	\$	
Meter	-----	in. at	-----	\$	
Lead Joints	-----	at	-----	\$	
Leadite Joints	-----	at	-----	\$	
Hrs. Foreman	-----	at	-----	\$	
Hrs. Chauffeur	-----	at	-----	\$	
Hrs. Tapper	-----	at	-----	\$	
Hrs. Labor	-----	at	-----	\$	
Hrs. Labor	-----	at	-----	\$	
Hrs. Compressor	-----	at	-----	\$	
Compensation Ins.	-----		-----	\$	
Trucking	-----		-----	\$	
Builders Use of Water	-----		-----	\$	
			-----	\$	
			-----	\$	
St.

Pl


*Glen*

Ave. No. *178*

Name of Owner

Labor and Mat'l. Report

19*14*

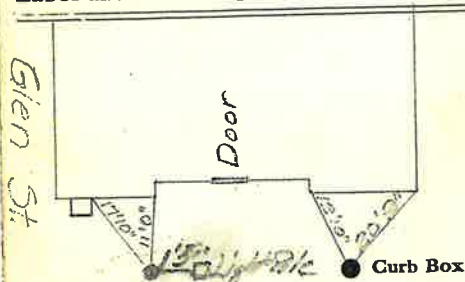

Main *South St.* Elev. of Main at tap

Gate at ● Gate at ●

● Curb Box

### Labor and Materials

Copper	}	Connection.....	\$	
Lead				
Curb	}	Cock	in	\$
		Valve		
		T. S. & V.		
Service Box	}	Short 3½ x 4½	in	\$
Old returned		Long 4½ x 5½		
		Buff. or Rdway		
Ft. ....	}	Copper	Pipe at	\$
in. ....		Galv Iron		
		Cast Iron		
Nipples		in. at	\$	
Bushings		to .. in. at	\$	
Red's	}	Conplings..... to .. in. at	\$	
Inc'g				
Union		in. at	\$	
Meter		in. at	\$	
Lead Joints		at	\$	
Leadite Joints		at	\$	
Hrs. Foreman		at	\$	
Hrs. Chauffeur		at	\$	
Hrs. Tapper		at	\$	
Hrs. Labor		at	\$	
Hrs. Labor		at	\$	
Hrs. Compressor		at	\$	
Compensation Ins.			\$	
Trucking			\$	
Builders Use of Water			\$	
			\$	
			\$	
St.   
 Pt.   
 Ave. No. 178

Glen

---

Name of Owner  
*OC Smith*

---

Labor and Mat'l. Report *Sept 4* 19*25*

Glen St.

Driveway through tiled.

24-0  
 15-5  
 ● Curb Box

---

10" Main *South St.* Elev. of Main at tap *6'*

Gate at ●
● Gate at

---

● Curb Box

*Box was by Light Pole*

*200*

*This service is for barbar shop #12 South St.*

*or #14*

*This tap shot off at Curb Building razed.*