

# LABOR AND MATERIALS


Copper } Connection _____ \$ _____	
Lead } _____ \$ _____	
1 Cook Valve } 12" x 6" in. _____ \$ _____	
1 T.S. & V. } _____ \$ _____	
1 Service box { Short 3-1/2 x 4-1/2 } GATE BOX _____ \$ _____	
Old returned { Long 4-1/2 x 5-1/2 } _____ \$ _____	
39' Ft. 6" in. { Copper } Pipe at _____ \$ _____	
_____ Nipples _____ in. at _____ \$ _____	
_____ Bushings _____ to _____ in. at _____ \$ _____	
_____ Red'g _____	
_____ Inc'g _____	
_____ Union _____ in. at _____ \$ _____	
_____ Meter _____ in. at _____ \$ _____	
_____ _____ \$ _____	
_____ Compound Joints at _____ \$ _____	
_____ Maintenance Foreman _____ \$ _____	
_____ Hrs. Water Maint. Man - 1 at _____ \$ _____	
_____ Hrs. Water Maint. Man - 2 at _____ \$ _____	
_____ Hrs. Garage Foreman _____ at _____ \$ _____	
_____ Hrs. Labor _____ at _____ \$ _____	
_____ Hrs. Compressor at _____ \$ _____	
_____ _____ \$ _____	
_____ Trucking _____ \$ _____	
_____ Pav't Patch _____ \$ _____	
_____ _____ \$ _____	
_____ _____ \$ _____	
_____ _____ \$ _____	
_____ _____ \$ _____	

GLEN

St. \_\_\_\_\_  
 Ave. No. 288-292

Name of Owner  
 McPHILLIPS

Labor and Mat'l. Report 1930, Nov. 13

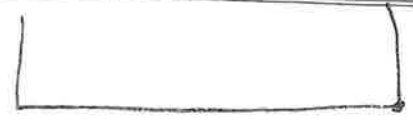

56'2"      90'5"

● Gate Box  
 GATE

12" Main

Elev. of Main at tap 6'

Gate at ●      ● Gate at

● Curb Box

### LABOR AND MATERIALS

Copper	}	Connection			\$
Lead					
Curb	{	Cock Valve T. S. & V.			
Service Box	{	Short 3/2x4 1/2 Long 4 1/2x5 1/2 Buff. or Rdway			
Old returned					
Ft. in.	{	Copper Galv Iron Cast Iron			
Nipples		in. at			
Bushings		to in. at			
Red'g Inc'g	{	Couplings			
Union		in. at			
Meter		in. at			
Lead Joints		at			
Leadite Joints		at			
Hrs. Foreman		at			
Hrs. Chauffeur		at			
Hrs. Tapper		at			
Hrs. Labor		at			
Hrs. Labor		at			
Hrs. Compressor		at			
Compensation Ins.					
Trucking					
Builders Use of Water					

288-292  
 St. \_\_\_\_\_  
 Pt. \_\_\_\_\_  
 Ave. No. 192

---

Name of Owner \_\_\_\_\_

---

**Labor and Mat'l. Report**

1914

● Curb Box

---

Main	Elev. of Main at tap
Gate at ●	● Gate at

● Curb Box

LABOR AND MATERIALS

1	Copper Lead	{ Connection	1 1/2"	\$	13.10
1	Curb	{ Cock Valve F.S. & V.	1 1/2" in.	\$	11.55
1	Service box Old returned	{ Short 3 1/2 x 4 1/2 Long 4 1/2 x 5 1/2 Buff or Rdway		\$	10.00
41	Ft. 1 1/2 in.	{ Copper C.I. C.I.	Pipe at 79	\$	32.39
	Nipples	in. at		\$	
	Bushings	to in. at		\$	
2	Red'g Ins'g	{ Coupl'gs	1 1/2" to 1 1/2" in. at 80	\$	1.60
	Union	in. at		\$	
	Meter	in. at		\$	
	Lead Joints at			\$	
	Compound Joints at			\$	
	Hrs. Water Maint. Man-1 at			\$	
14	Hrs. Water Maint. Man-2 at	1.02		\$	14.28
	Hrs. Labor	at		\$	
42	Hrs. Labor	at 91		\$	38.22
4	Hrs. Compressor at	1.20		\$	4.80
	Compensation Ins. at \$2.226 per C.			\$	1.17
	Trucking			\$	1.17
	Pav't Patch			\$	22.52
	Tap by Warsinski			\$	
	O'head			\$	
				\$	151.63

12811

1952

Glen


St. Pl. Ave. No. 288

Name of Owner

McPhillips

Labor and Mat'l. Report

Oct 26 19 50

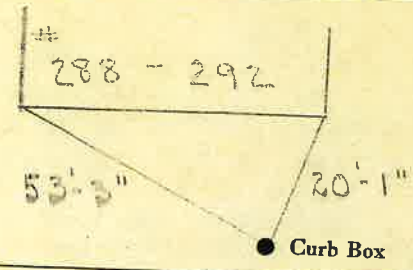

12 Main

Elev. of Main at tap 6'

Gate at ●

● Gate at

● Curb Box