

330 Glen St

Tap made _____ 19____

● Curb Box

_____ in. Main Elev. of Main at tap _____

Gate at ● ● Gate at


● Curb Box

Transferred to:
 City Map _____
 Street Profile _____
 Curb Box Record _____

(GIVEN TO PAYER)

330 Glen St

Pit Meter 2"

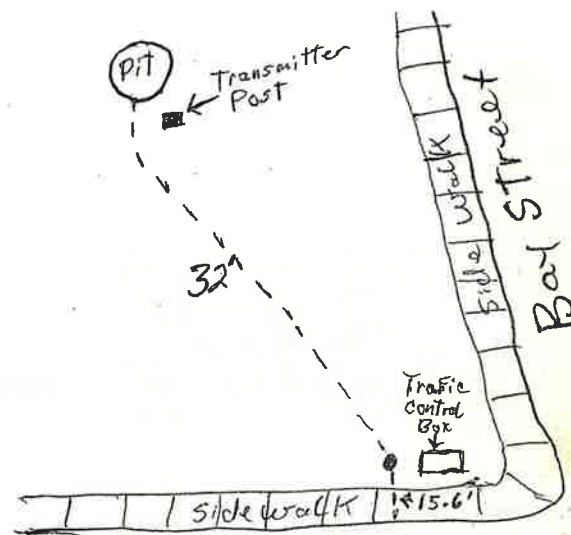

Glen Street