

Labor and Materials

Copper } Connection.....	3	\$ 2.70
Lead }		
Curb } Cock Valve }	3	\$ 2.39
} T. S. & V. }		
Service Box } Short 3/4x1/2 }		\$ 1.45
Old returned } Long 1/2x3/4 }		
} Buff. or Rdway }		
10 Ft. in. } Copper Galv. Iron } Pipe at	3	\$ 2.70
} Cast Iron }		
Nipples..... in. at.....		\$
Bushings..... to..... in. at.....		\$
Red'g } Couplings..... to..... in. at.....		\$
Inc'g }		
Union..... in. at.....		\$
Meter..... in. at.....		\$
Lbs. Br. Stone at.....		\$
Lbs. Sand at.....		\$
Bags Cement at.....		\$
Paving Brick } Mack } at.....		\$
} Red }		
} Asphalt }		
Lead Joints at.....		\$
Leadite Joints at.....		\$
5 Hrs. Foreman at.....		\$ 5.13
18 Hrs. Common Labor at.....		\$ 8.10
Hrs. Common Labor at.....		\$
Hrs. Mason at.....		\$
Hrs. Mason's Helper at.....		\$
7 Hrs. Compressor at.....		\$ 3.00
Compensation Ins.....		\$ 35
Trucking.....		\$ 1.00
Builders' Use of Water.....	Patch	\$ 25.00
Total \$		49.82

30-121 363 GLEN

Labor and Material Report Sept 19

225 Glen St

● Curb Box

12" Main Eley of Main at tap

Gate at ● ● Gate at

● Curb Box

Old Tap to be discon on Harlem St.

225 Glen St 1930 46' 7" 45'
 12" main 5' elev
 Old tap to be discon on Harlem St


Labor and Materials

Copper } Connection.....	\$
Lead } Connection.....	\$
Curb { Cock }	in. \$
{ Valve }	in. \$
{ T. S. & V. }	in. \$
Service Box { Short 3 1/2 x 4 1/2 }	\$
Old returned { Long 4 1/2 x 5 1/2 }	\$
{ Buff. or Rdway }	\$
Ft. in. { Copper } Pipe at.....	\$
{ Galv. Iron }	\$
{ Cast Iron }	\$
Nipples..... in. at.....	\$
Bushings..... to..... in. at.....	\$
Red'g } Couplings..... to..... in. at.....	\$
Inc'g } Couplings..... to..... in. at.....	\$
Union..... in. at.....	\$
Meter..... in. at.....	\$
Lbs. Br. Stone at.....	\$
Lbs. Sand at.....	\$
Bags Cement at.....	\$
Paving Brick { Mack } at.....	\$
{ Red }	\$
{ Asphalt }	\$
Lead Joints at.....	\$
Leadite Joints at.....	\$
Hrs. Foreman at.....	\$
Hrs. Common Labor at.....	\$
Hrs. Common Labor at.....	\$
Hrs. Mason at.....	\$
Hrs. Mason's Helper at.....	\$
Hrs. Compressor at.....	\$
Compensation Ins.....	\$
Trucking.....	\$
Builders' Use of Water.....	\$
Total \$.....	

Labor and Material Report

May 6 1906

Curb Box at 285 Glass.

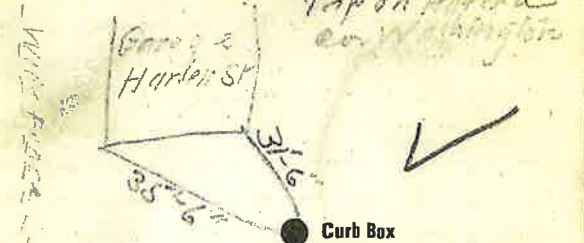

Gate at ● Main Elev. of Main at tap Gate at ●

● Curb Box

Shut off at curb
Nov. 16, 1939.