


LABOR AND MATERIALS

1	Copper	Connection	_____	\$	_____
1	Curb	Cock Valve	_____ in.	\$	_____
	Service box	Short 3-1/2 x 4-1/2	_____	\$	_____
	Old returned	Long 4-1/2 x 5-1/2	_____	\$	_____
11	Ft. 3/4 in.	Copper Pipe	at _____	\$	_____
	Nipples	_____ in.	at _____	\$	_____
	Bushings	_____ to _____ in.	at _____	\$	_____
	Red'g				
	Inc'g				
	Union	_____ in.	at _____	\$	_____
	Meter	_____ in.	at _____	\$	_____
				\$	_____
	Compound Joints	at _____		\$	_____
	Maintenance Foreman			\$	_____
	Hrs. Water Maint. Man - 1	at _____		\$	_____
	Hrs. Water Maint. Man - 2	at _____		\$	_____
	Hrs. Garage Foreman	at _____		\$	_____
	Hrs. Labor	at _____		\$	_____
	Hrs. Compressor	at _____		\$	_____
				\$	_____
	Trucking			\$	_____
	Pav't Patch			\$	_____
				\$	_____
				\$	_____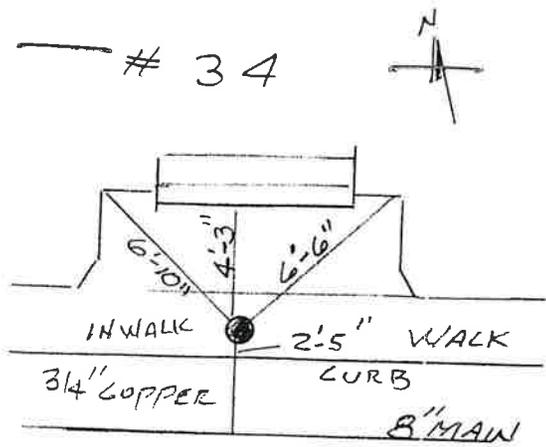
5'± TO MAIN

ELEV TO TAP 5.5'±

SEPT 2006