


### LABOR AND MATERIALS

Copper	} Connection	_____	\$ _____		
Lead					
Curb	} Cock	_____ in.	\$ _____		
				} Valve	
					} T. S. & V.
Service box	} Short 3½ x 4½	_____	\$ _____		
Old returned				} Long 4½ x 5½	
Ft. 3/4 in.	} { Copper G.I. G.I. }	} Pipe at _____	\$ _____		
Nipples _____ in.				at _____	
Bushings _____ to _____ in.				at _____	
Red'g } Inc'g }	} Coupl'gs _____ to _____ in.	at _____	\$ _____		
Union _____ in.				at _____	
Meter _____ in.	at _____	\$ _____			
Compound Joints	at _____	\$ _____			
Maintenance Foreman		\$ _____			
Hrs. Water Maint. Man	1 at _____	\$ _____			
Hrs. Water Maint. Man	2 at _____	\$ _____			
Hrs. Garage Foreman	at _____	\$ _____			
Hrs. Labor	at _____	\$ _____			
Hrs. Compressor	at _____	\$ _____			
Trucking		\$ _____			
Pav't Patch		\$ _____			
		\$ _____			
		\$ _____			
		\$ _____			
		\$ _____			

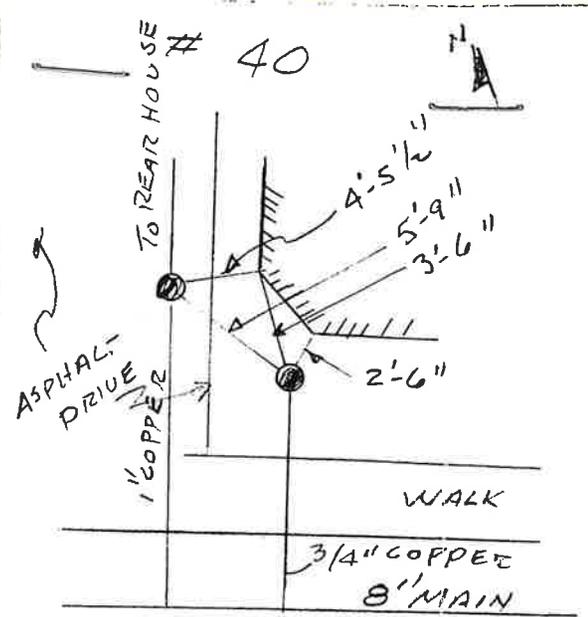

10'± TO MAIN  
ELEV TO TAP 6'±

SEP 2006

## LABOR AND MATERIALS

Copper	} Connection	-----	\$	
Lead				
Curb	} Cock Valve T. S. & V.	----- in.	\$	
Service Box				
Old returned	} Short 3 1/2 x 4 1/2 Long 4 1/2 x 5 1/2 Buff. or Rdway	-----	\$	
Ft.		} Copper Galv Iron Cast Iron	} Pipe at -----	\$
in.				
Nipples	in. at -----	\$		
Bushings	to ----- in. at -----	\$		
Red'g Inc'g	} Couplings	to ----- in. at -----	\$	
Union		in. at -----	\$	
Meter	in. at -----	\$		
Lead Joints	at -----	\$		
Leadite Joints	at -----	\$		
Hrs. Foreman	at -----	\$		
Hrs. Chauffeur	at -----	\$		
Hrs. Tapper	at -----	\$		
Hrs. Labor	at -----	\$		
Hrs. Labor	at -----	\$		
Hrs. Compressor	at -----	\$		
Compensation Ins.	-----	\$		
Trucking	-----	\$		
Builders Use of Water	-----	\$		
	-----	\$		
	-----	\$		
	-----	\$		
	-----	\$		

St. 40  
 Pl. \_\_\_\_\_  
 Ave. No. 34

*Goodwin*

Name of Owner \_\_\_\_\_

---

Labor and Mat'l. Report Aug. 21 19-39

#30  
*Goodwin*

40

#34  
*Goodwin (Shop)*

#30  
*Goodwin*

46-11" 58-0"  
Curb Box

---

Main
Elev. of Main at tap

Gate at ●
Gate at ●

● Curb Box