


LABOR AND MATERIALS

| | | | |
|---|-----------------------------------|-----------|----|
| 1 | Copper } Connection | 3/4 | \$ |
| 1 | Curb } Cock Valve T.S. & V. | 3/4 in. | \$ |
| 1 | Service box } Short 3-1/2 x 4-1/2 | | \$ |
| | Old returned } Long 4-1/2 x 5-1/2 | | \$ |
| 5 | Ft. 3/4 in. } Copper G.I. G.I. | Pipe at | \$ |
| | Nipples | in. at | \$ |
| | Bushings | to in. at | \$ |
| | Red'g | | |
| | Inc'g | | |
| | Union | in. at | \$ |
| | Meter | in. at | \$ |
| | | | \$ |
| | Compound Joints at | | \$ |
| | Maintenance Foreman | | \$ |
| | Hrs. Water Maint. Man - 1 at | | \$ |
| | Hrs. Water Maint. Man - 2 at | | \$ |
| | Hrs. Garage Foreman | at | \$ |
| | Hrs. Labor | at | \$ |
| | Hrs. Compressor at | | \$ |
| | | | \$ |
| | Trucking | | \$ |
| | Pav't Patch | | \$ |
| | | | \$ |
| | | | \$ |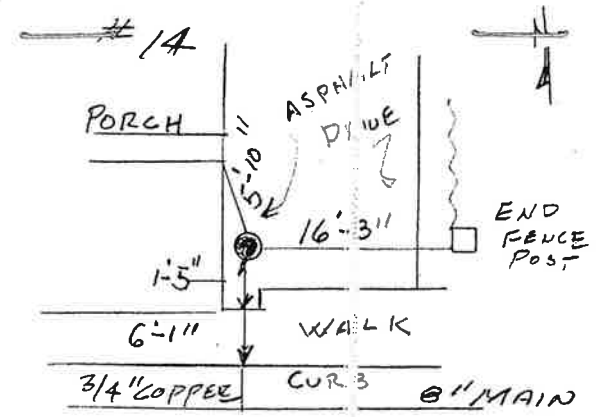
7' TO MAIN

ELEV TO TAP 5.5'

TAX ID # 302.20-6-25

SEPT 2006