


LABOR AND MATERIALS

1	Copper Lead } Connection	3/4	\$	_____
1	Curb } Cock Valve } F.S. & V.	3/4 in.	\$	_____
1	Service box } Short 3-1/2 x 4-1/2 } Old returned } Long 4-1/2 x 5-1/2 }		\$	_____
7	Ft. 3/4 in. } Copper } Gt. } Et. }		\$	_____
_____	Nipples _____ in. at _____		\$	_____
_____	Bushings _____ to _____ in. at _____		\$	_____
_____	Red'g _____		\$	_____
_____	Inc'g _____		\$	_____
_____	Union _____ in. at _____		\$	_____
_____	Meter _____ in. at _____		\$	_____
_____	_____		\$	_____
_____	Compound Joints at _____		\$	_____
_____	Maintenance Foreman _____		\$	_____
_____	Hrs. Water Maint. Man - 1 at _____		\$	_____
_____	Hrs. Water Maint. Man - 2 at _____		\$	_____
_____	Hrs. Garage Foreman _____ at _____		\$	_____
_____	Hrs. Labor _____ at _____		\$	_____
_____	Hrs. Compressor at _____		\$	_____
_____	_____		\$	_____
_____	Trucking _____		\$	_____
_____	Pav't Patch _____		\$	_____
_____	_____		\$	_____
_____	_____		\$	_____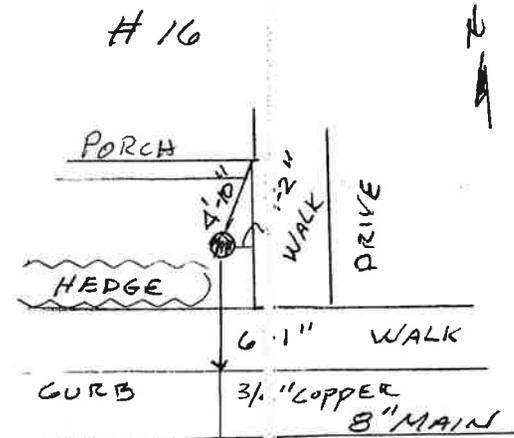
9' 1/4 TO MAIN
 ELEG TO TAP 5.5'

SEPT-2006

Old tap 5.10'