

LABOR AND MATERIALS


Copper	Lead	Connection	3/4		\$ 2.29
1	Curb	Cock Valve F.S. & V.	3/4 in.		\$ 2.70
1	Service box Old returned	Short 3 1/2 x 4 1/2 Long 4 1/2 x 5 1/2 Buff or Rdway			\$ 4.25
266	Ft.	3/4 in. Copper G.I. G.I.	Pipe at	35	\$ 9.10
	Nipples		in. at		\$
	Bushings		to in. at		\$
	Red'g Inc'g	Coupl'gs	to in. at		\$
	Union		in. at		\$
	Meter		in. at		\$
	Lead Joints at				\$ 13.40
	Compound Joints at				\$
	Hrs. Water Maint. Man-1		at		\$
6/8	Hrs. Water Maint. Man-2		at		\$ 6.12
	Hrs. Labor		at	91	\$ 9.28
	Hrs. Labor		at		\$
	Hrs. Compressor at				\$
	Compensation Ins. at \$		per C.		\$ 30
	Trucking				\$ 1.00
	Pav't Patch	B.P.			\$
	O'head				\$
					\$ 33.04

115-1650 BzSonz Taving

St. Grand
Pl. 18
Ave. No. 18

Name of Owner Raymond Shaw

Labor and Mat'l. Report July 5 1950

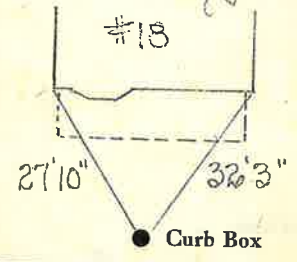

4" Main Elev. of Main at tap 5
Gate at ● ● Gate at

● Curb Box