


LABOR AND MATERIALS

_____	Copper	} Connection _____	\$ _____
_____	Lead		\$ _____
<u>1</u>	Curb	} Cock Valve } <u>3/4</u> in.	\$ _____
_____			T.S. & V. }
_____	Service box	{ Short 3-1/2 x 4-1/2 }	\$ _____
_____	Old returned		{ Long 4-1/2 x 5-1/2 }
<u>37</u>	Ft.	{ Copper } Pipe at	\$ _____
<u>3/4</u>	in.		{ } }
_____	Nipples	_____ in. at	\$ _____
_____	Bushings	_____ to _____ in. at	\$ _____
_____	Red'g		\$ _____
_____	Inc'g		\$ _____
_____	Union	_____ in. at	\$ _____
_____	Meter	_____ in. at	\$ _____
_____			\$ _____
_____	Compound Joints at		\$ _____
_____	Maintenance Foreman		\$ _____
_____	Hrs. Water Maint. Man - 1 at		\$ _____
_____	Hrs. Water Maint. Man - 2 at		\$ _____
_____	Hrs. Garage Foreman	_____ at	\$ _____
_____	Hrs. Labor	_____ at	\$ _____
_____	Hrs. Compressor at		\$ _____
_____			\$ _____
_____	Trucking		\$ _____
_____	Pav't Patch		\$ _____
_____			\$ _____
_____			\$ _____
St. GRAND
 Ave. No. 22
 Name of Owner FRASIER

Labor and Mat'l. Report 1961, Nov. 8

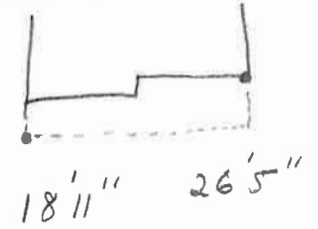

● Curb Box

4" Main

Elev. of Main at tap 5'

Gate at ● ● Gate at

TAX ID # 302.16-17-42

● Curb Box

CURB BOX INSIDE OF WALK