

### LABOR AND MATERIALS

1	Copper	{ Connection	3/4"	\$	2.29
1	Lead				
1	Curb	{ Cock Valve F.S. & V. }	3/4 in.	\$	2.70
1	Service box	{ Short 3 1/2 x 4 1/2 Long 4 1/2 x 5 1/2 Buff or Rdway }		\$	4.25
8	Ft.	{ Copper G.I. C.I. }	Pipe at 35	\$	2.80
	Nipples	in. at		\$	
	Bushings	to in. at		\$	
	Red'g	{ Coupl'gs to in. at		\$	
	Ing'g			\$	
	Union	in. at		\$	
	Meter	in. at		\$	4.50
	Lead Joints at			\$	1.50
	Compound Joints at			\$	
1	Hrs. Water Maint. Man	1 at		\$	1.12
6	Hrs. Water Maint. Man	2 at		\$	6.12
8	Hrs. Labor	at		\$	7.28
	Hrs. Labor	at		\$	
	Hrs. Compressor at			\$	
	Compensation Ins. at \$	per C.		\$	32
	Trucking			\$	1.00
	Pav't Patch	B.P.		\$	
	O'head			\$	
				\$	27.88

12-1-1950

Before Taring

Grand


St. Fr. Ave. No. 23

Name of Owner

Fred Beckwith

Labor and Mat'l. Report

July 5 1950

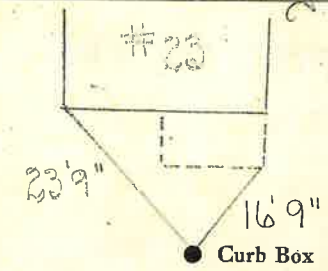

4" Main

Elev. of Main at tap 5'

Gate at ●

● Gate at

● Curb Box