

LABOR AND MATERIALS


1	Copper	{ Connection	3/4	\$	2.29
1	Lead				
1	Curb	{ Cock Valve	3/4 in.	\$	2.70
		{ F.S. & V.			
1	Service box	{ Short 3 1/2 x 4 1/2		\$	4.25
	Old returned	{ Long 4 1/2 x 5 1/2			
		{ Buff or Rdway			
266	Ft. 3/4 in.	{ Copper	Pipe at 35	\$	9.10
		{ C.I.			
	Nipples	in. at		\$	
	Bushings	to in. at		\$	
	Red'g	{ Coupl'gs	to in. at	\$	
	Inc'g				
	Union	in. at		\$	
	Meter	in. at		\$	
	Lead Joints at			\$	9.13
	Compound Joints at			\$	
2	Hrs. Water Maint. Man-1	at		\$	2.24
1	Hrs. Water Maint. Man-2	at		\$	1.02
7	Hrs. Labor	at 91		\$	6.37
	Hrs. Labor	at		\$	
	Hrs. Compressor at			\$	
	Compensation Ins. at \$	per C.		\$	21
	Trucking			\$	1.21
	Pav't Patch	B.P.		\$	
	O'head			\$	
				\$	29.18

125-1458 Before Taving

St. Grand
 Pl. 28
 Ave. No. 28

Name of Owner Max Mazer

Labor and Mat'l. Report July 5 19 50

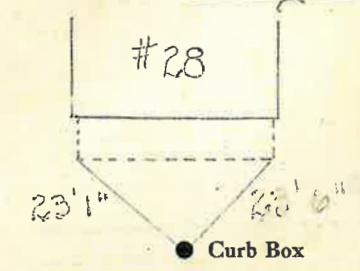

4 Main Elev. of Main at tap 5
 Gate at ● Gate at ●

TAX ID # 302.16-17-45

● Curb Box