

LABOR AND MATERIALS

1 Copper { Connection $\frac{3}{4}$ " } \$ 2.29
 1 Lead { }
 1 Curb { Cock Valve } $\frac{3}{4}$ in. \$ 2.70
 F.S. & V.
 1 Service box { Short $3\frac{1}{2} \times 4\frac{1}{2}$ }
 Old returned { Long $4\frac{1}{2} \times 5\frac{1}{2}$ } \$ 4.25
 Buff-or-Rdway
 8 Ft. $\frac{3}{4}$ in. { Copper } Pipe at 35 \$ 2.80
 { G.I. }
 { C.I. }
 Nipples in. at \$
 Bushings to in. at \$
 Red'g { Coupl'gs to in. at \$
 Inc'g { }
 Union in. at \$
 Meter in. at \$
 Lead Joints at \$
 Compound Joints at \$
 1 Hrs. Water Maint. Man-1 at \$ 1.12
 1 Hrs. Water Maint. Man-2 at \$ 1.02
 9 Hrs. Labor at \$ 8.19
 Hrs. Labor at \$
 Hrs. Compressor at \$
 Compensation Ins. at \$ per C. \$ 23
 Trucking \$ 1.
 Pav't Patch B.P. \$
 \$
 \$
 \$
 O'head \$
 \$23.60

116-1150


Before Paving

St.
 Pl:
 Ave. No. 33

Grand

Name of Owner
 Buzell G. Brayton

Labor and Mat'l. Report July 6 19 50

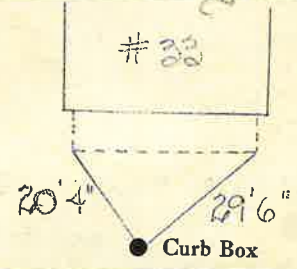

4 Main Elev. of Main at tap 5
 Gate at ● Gate at ●

● Curb Box