

# LABOR AND MATERIALS


1	Copper } Connection	3/4	\$
1	Curb } Cock Valve T.S. & V.	3/4 in.	\$
1	Service box } Old returned	{ Short 3-1/2 x 4-1/2 } { Long 4-1/2 x 5-1/2 }	\$
5	Ft. } Copper } Pipe at	3/4 in.	\$
	Nipples	in. at	\$
	Bushings	to in. at	\$
	Red'g		
	Inc'g		
	Union	in. at	\$
	Meter	in. at	\$
	Compound Joints at		\$
	Maintenance Foreman		\$
	Hrs. Water Maint. Man - 1 at		\$
	Hrs. Water Maint. Man - 2 at		\$
	Hrs. Garage Foreman at		\$
	Hrs. Labor at		\$
	Hrs. Compressor at		\$
	Trucking		\$
	Pav't Patch		\$
			\$
			\$
GRAND

St. Ave. No. 37

Name of Owner

Labor and Mat'l. Report 19 28, JUNE 19

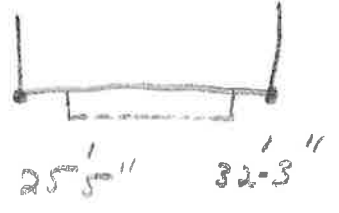

● Curb Box

4" Main (GALV)

Elev. of Main at tap 5'

Gate at ●

● Gate at

5' to main

● Curb Box

OLD TAP TO BE SHUT OFF