

Labor and Materials


1	Copper	Connection	3/4"	\$	96
1	Lead				
1	Curb	Cock Valve T.S.&V.	3/4" in	\$	1.33
1	Service Box	Short 3 1/2 x 4 1/2		\$	1.35
	Old returned	Long 4 1/2 x 5 1/2			
		Buff. or Rdway			
2 1/2	Ft.	Copper Galv. Iron Cast Iron	Pipe at 15	\$	3.75
	Nipples	in. at		\$	
	Bushings	to in. at		\$	
	Red'g Inc'g	Couplings	to in. at	\$	
	Union	in. at		\$	
	Meter	in. at		\$	
	Lbs. Br. Stone	at		\$	
	Lbs. Sand	at		\$	
	Bags Cement	at		\$	
	Paving Brick	Mack Red Asphalt	at	\$	
	Lead Joints	at		\$	
	Leadite Joints	at		\$	
3	Hrs.	Foreman	at 6.21 hr	\$	1.88
14	Hrs.	Common Labor	at 50	\$	7.00
16	Hrs.	Common Labor	at 45	\$	7.20
	Hrs.	Mason	at	\$	
	Hrs.	Masons Helper	at	\$	
	Hrs.	Compressor	at	\$	
	Compensation	Ins		\$	49
	Trucking			\$	1.19
	Builders Use of Water			\$	5.00

Total \$ 29.96

78-36 40

Labor and Material Report Aug 26 1936

39 Grand St - 1/2 tap
note

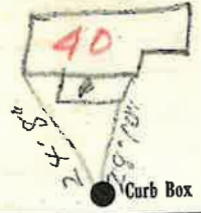

4" Main Elev of Main at tap 4
Gate at • Gate at •

Old tap shut off

TAX ID # 302.16-17-50

[Handwritten signature]